


T.34 S., R.1 W., W.M.

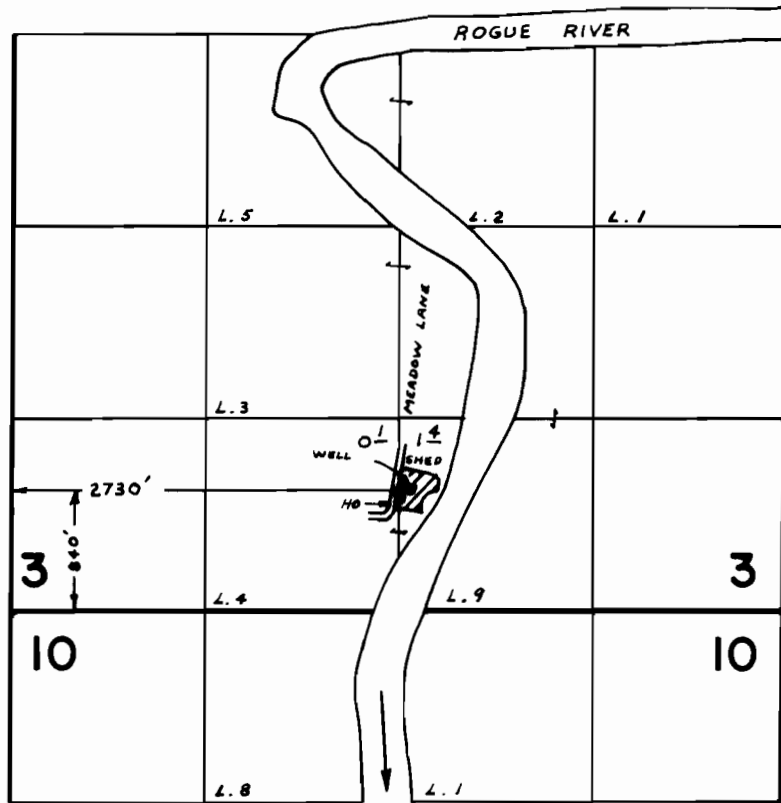

**FINAL PROOF SURVEY
UNDER**

Application No. G-6263 Permit No. G-5900 SUPPL.
IN NAME OF

J. E. &/OR JEANETTE A. ENYART

Surveyed OCT. 20 1978, by B. SUND