


T.36 S., R. 4 W., W.M.

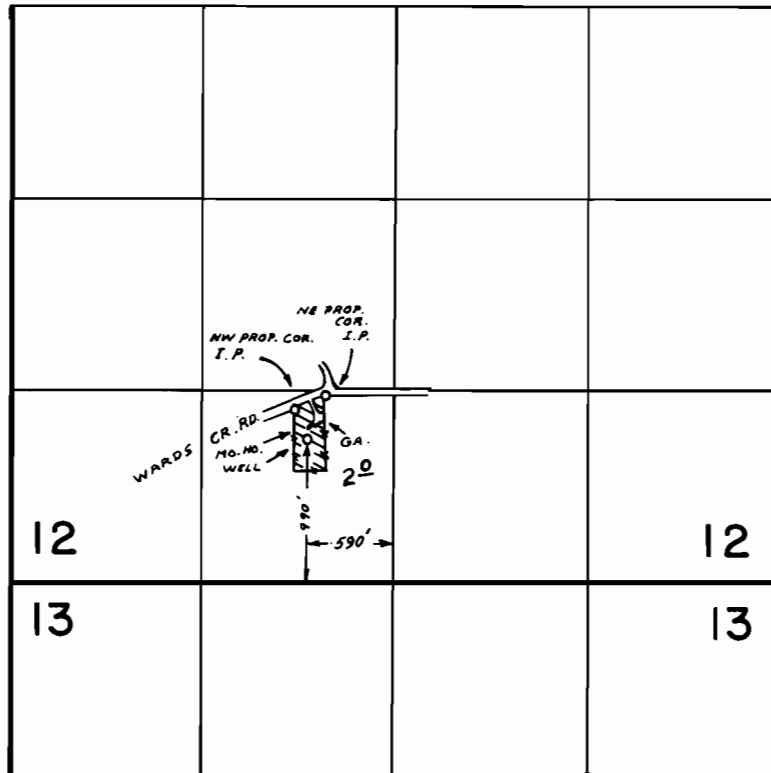

FINAL PROOF SURVEY UNDER

Application No. G-7301 Permit No. G-6752
IN NAME OF

MELVIN W. LEWIS

Surveyed MAY 17 78 by B. SUND
19....., by