


# T. 39 S., R. 1 E., W. M.

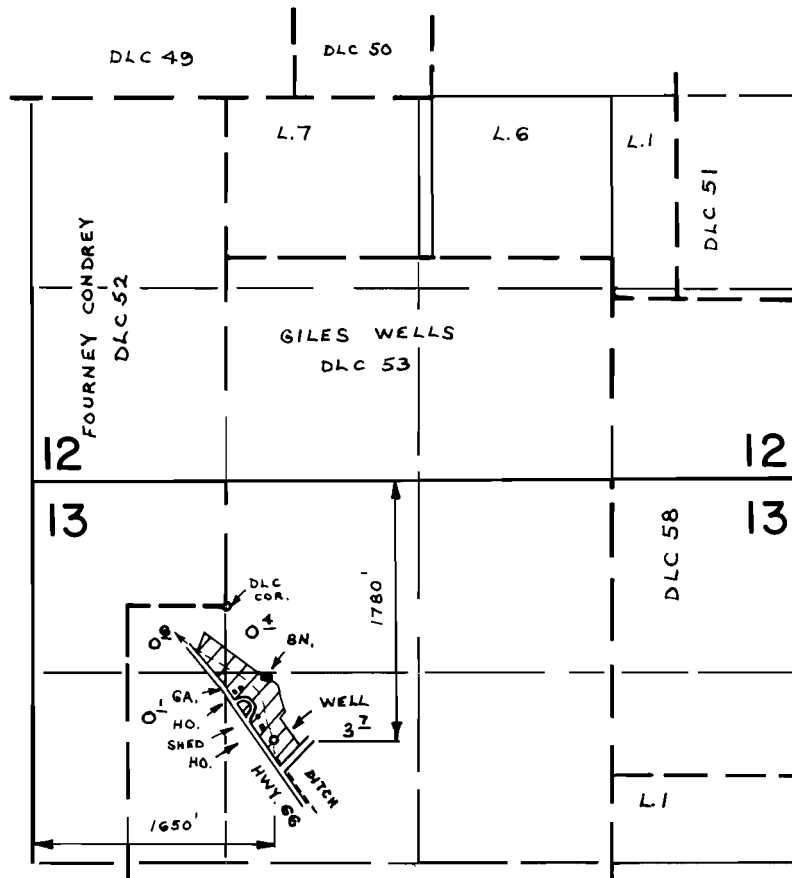

## FINAL PROOF SURVEY UNDER

Application No. G-7377 Permit No. G-6824 SUPPL.  
IN NAME OF

DELBERT TOBIASSON

Surveyed SEPT. 12 78 by B. SUND  
19

D.H.M.  
P.T.S. - 1978 - 14 - C