


T.2S.R.44E.W.M.

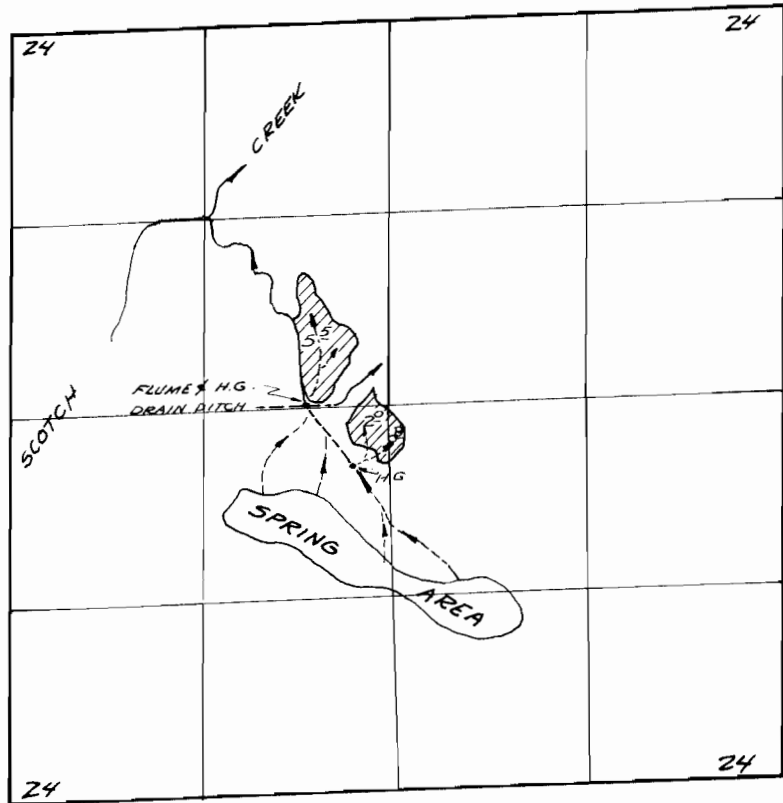

FINAL PROOF SURVEY UNDER

Application No. 9162... Permit No. 6031.....
IN NAME OF

DEAN SPRAQUE

Surveyed Oct 3, 1967, by *V. Gerner*.....