


# T. 35 S., R. 1 W., W.M.

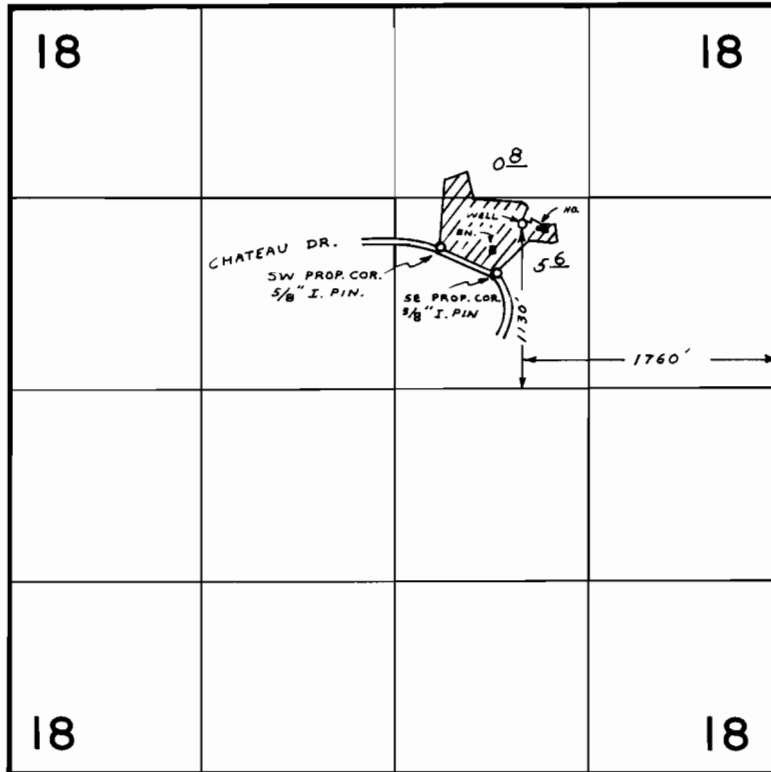

## FINAL PROOF SURVEY UNDER

Application No. G-7397 Permit No. G-6906  
IN NAME OF

HANS RINDERKNECHT

Surveyed MAY 30 1978, by B. SUND