


T.38S. R.4W. W.M.

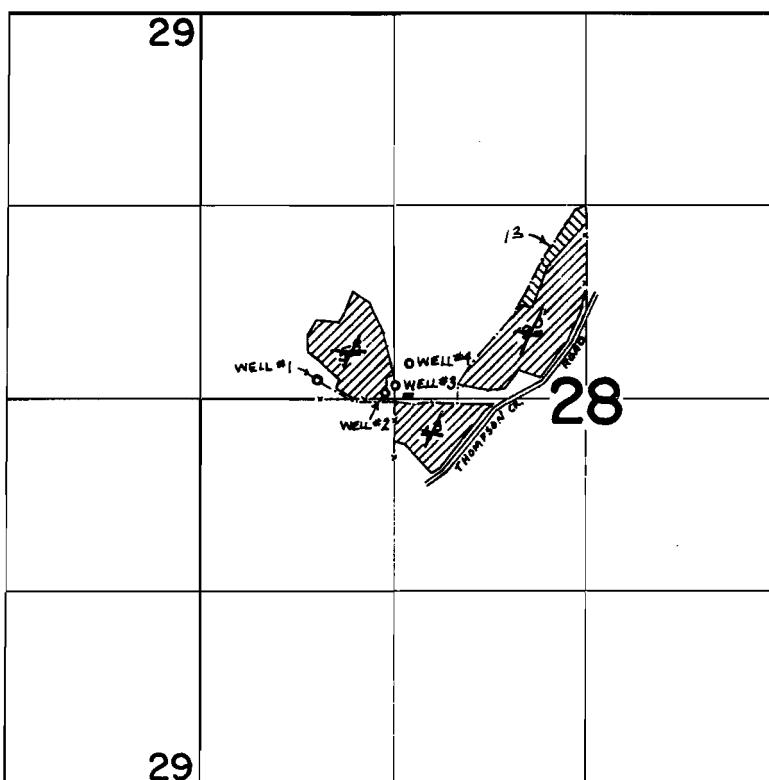

WELLS LOCATED: #1-130'N. & 530'W., #2-40'N. & 70'W., #3-90'N. & 10'E., #4-240'N. & 100'E.
ALL FROM SW COR. SE 1/4 NW 1/4 SEC. 28.

SUPPLEMENTAL IRRIGATION

Application No. **G-8303**

Permit No. **G 7705**

FINAL PROOF SURVEY

UNDER

~~Application No. G-5657 Permit No. G-5021~~

IN NAME OF

MR. OR MRS. D. G. MILLER

~~Surveyed AUG. 7 1975, by L. TOLL~~