


T.35 S., R.2 & 3 W., W.M.

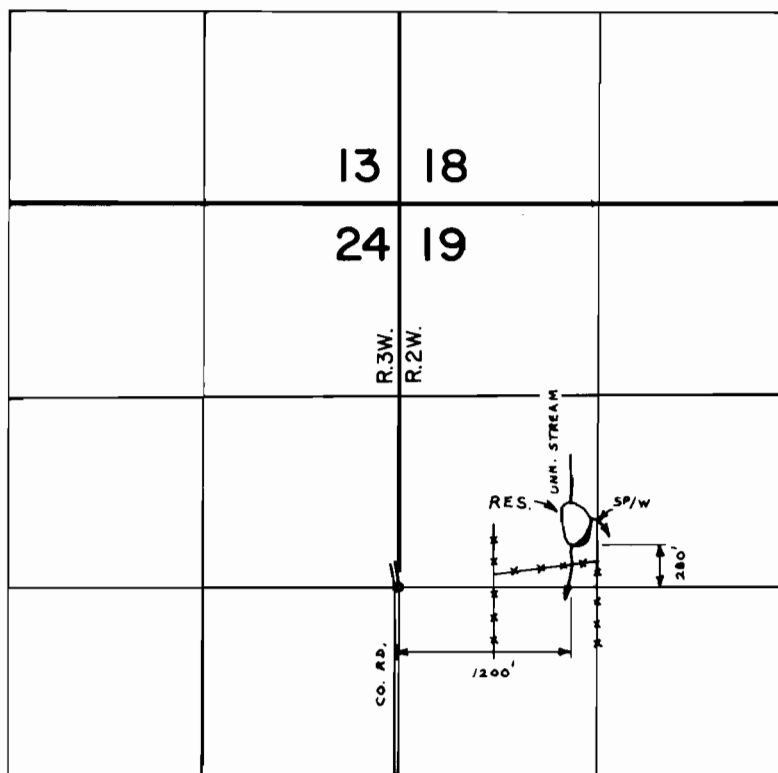

FINAL PROOF SURVEY
UNDER

Application No. R-46538 Permit No. R-5550
IN NAME OF
MILDRED V. MACK

Surveyed MAY 22 1978, by B. SUND

D.H.M.
P.T.S. - 1978 - 14 - A