



# T.36S.,R.4W.,W.M.

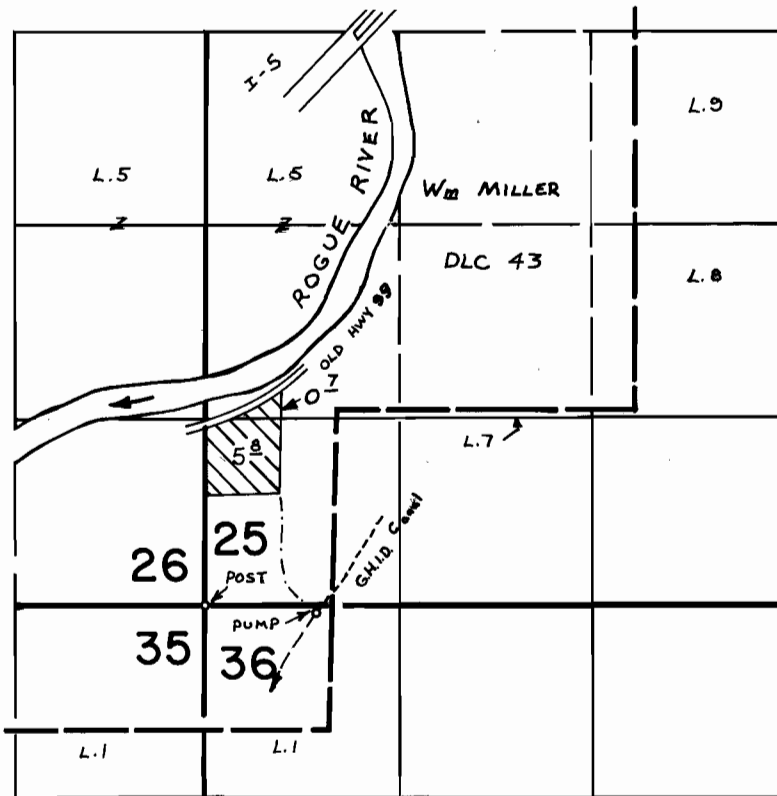

# T.36S.,R.3W.,W.M.

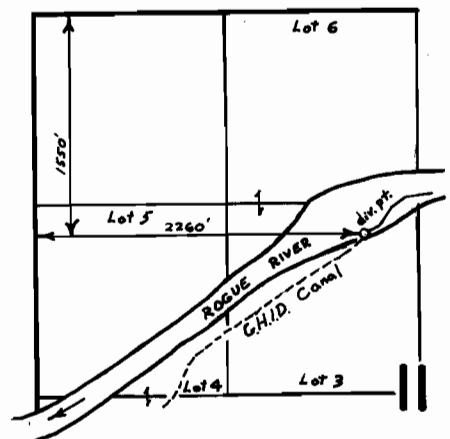

## FINAL PROOF SURVEY UNDER

Application No. 48069 Permit No. 36057  
IN NAME OF

ROMEY ULLIAN

Surveyed FEB. 22 19 78 by B. SUND

D.H.M.  
B50-10-5