


# T. 33 S., R. 1 E., W. M.

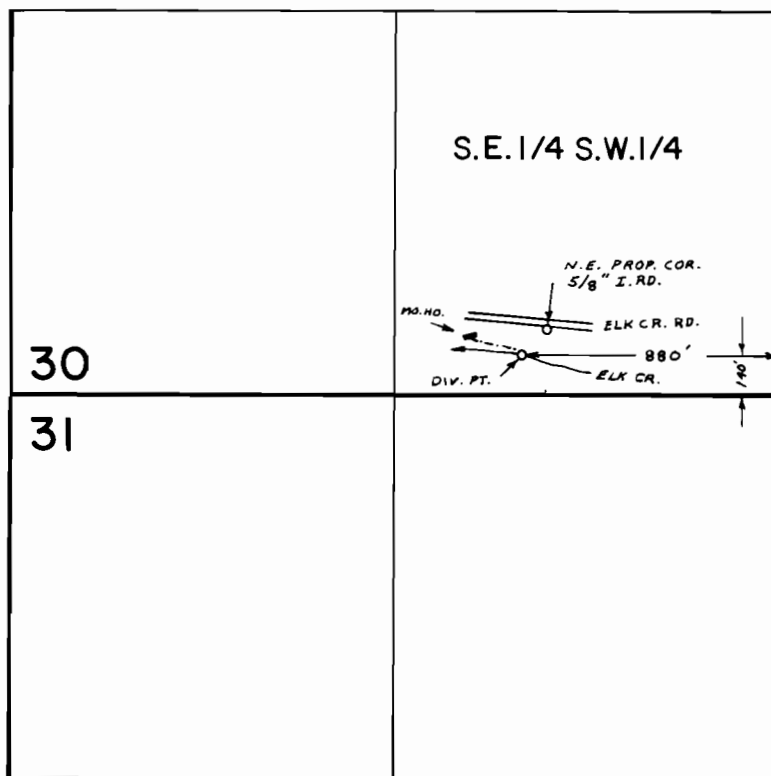

SCALE: 1" = 660 FT.

## FINAL PROOF SURVEY UNDER

Application No. 50133 Permit No. 37668  
IN NAME OF

LESTER & ELLEN RICHERTS

Surveyed AUG. 9 1978, by B. SUND