


T. 38 S., R. 3 W., W.M.

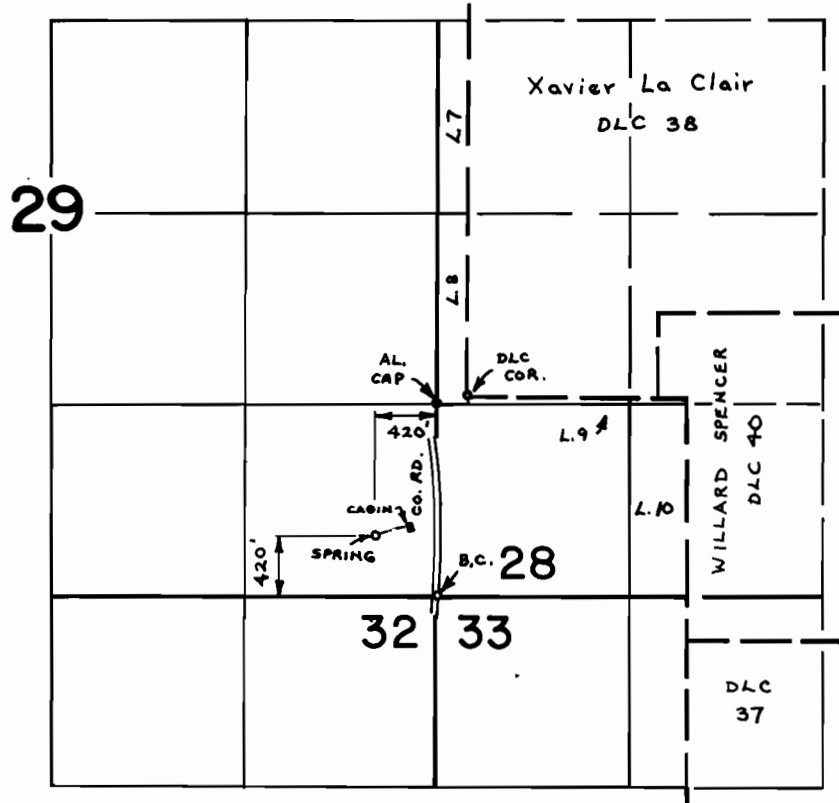

**FINAL PROOF SURVEY**  
UNDER

Application No. 50761 Permit No. 38336  
IN NAME OF

CHARLES F. FOGELQUIST

Surveyed JUN. 13 78 by B. SUND  
19.....

D.H.M.  
P.T.S. - 1978-14 - A