


T. 38 & 39 S., R. 3 W., W.M.

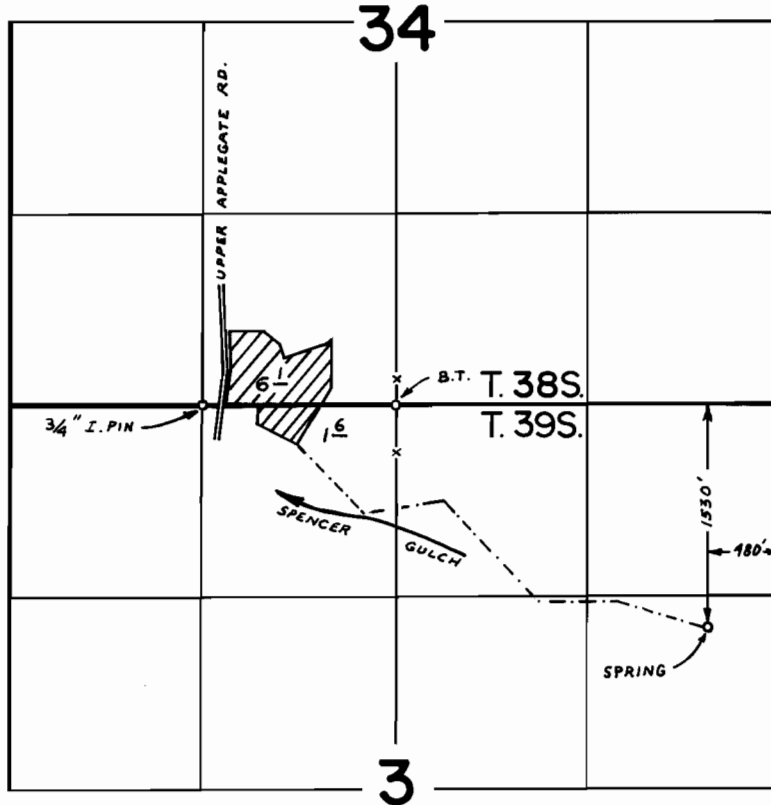

**FINAL PROOF SURVEY**  
UNDER

Application No. 51343 Permit No. 38760 SUPPL.  
IN NAME OF

MELVIN W. PARKER

Surveyed JUL. 7 1978, by B. SUND