


T. 35 S., R. 3 & 4 W., W.M

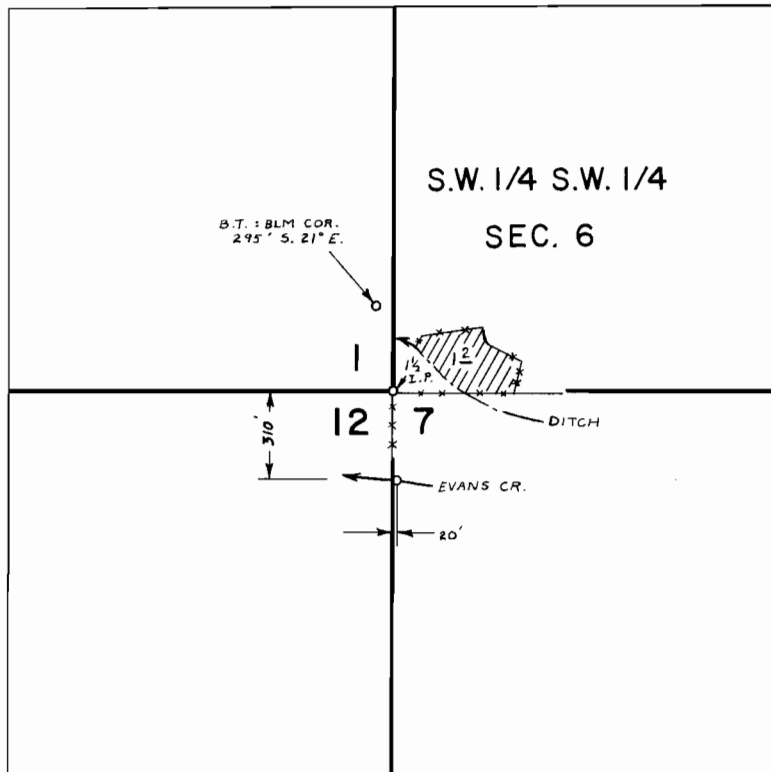

SCALE : 1" = 660 FT.

**FINAL PROOF SURVEY**  
UNDER

Application No. 53224 Permit No. 39496  
IN NAME OF  
NEAL VAN SLYKE

Surveyed MAY 17 1978, by B. SUND