


T. 36 S., R. 1 W., W.M.

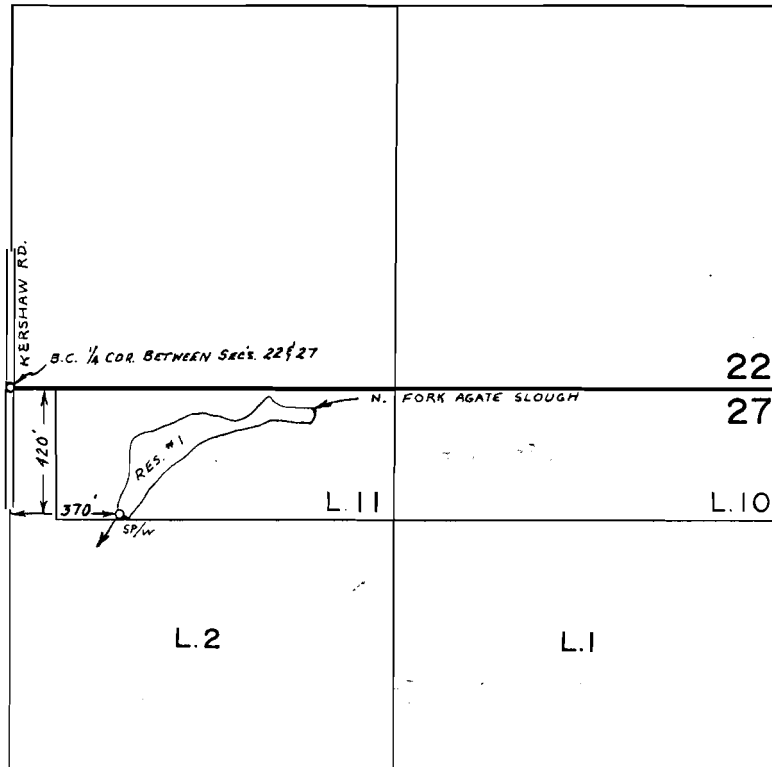

SCALE : 1" = 660 FT.

FINAL PROOF SURVEY UNDER

R-53632 R-6407
~~53633~~ 40120
 Application No. Permit No.
 IN NAME OF

JACKSON CO. PARKS & REC. DEPT.

Surveyed SEPT. 27 1978, by B. SUND