


T. 39 S., R. 8 W., W.M.

RECEIVED

DEC 22 1981

WM. DIST. 14
GRANTS PASS, ORE

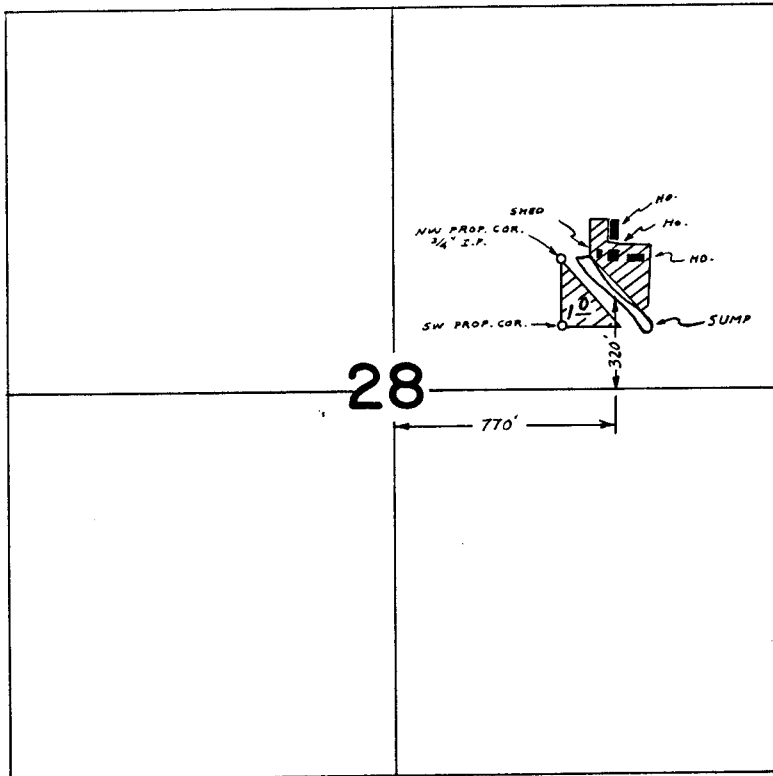

SCALE: 1" = 660 FT.

FINAL PROOF SURVEY
UNDER

Application No. G-5817 Permit No. G-5570
IN NAME OF

VERNON A. BRINKLEY

Surveyed AUG. 7 1978 by B. SUND

SUPPL.

P.T.S. - 1978 - 14 - C