


T. 34 & 35 S., R. 6 W., W.M.

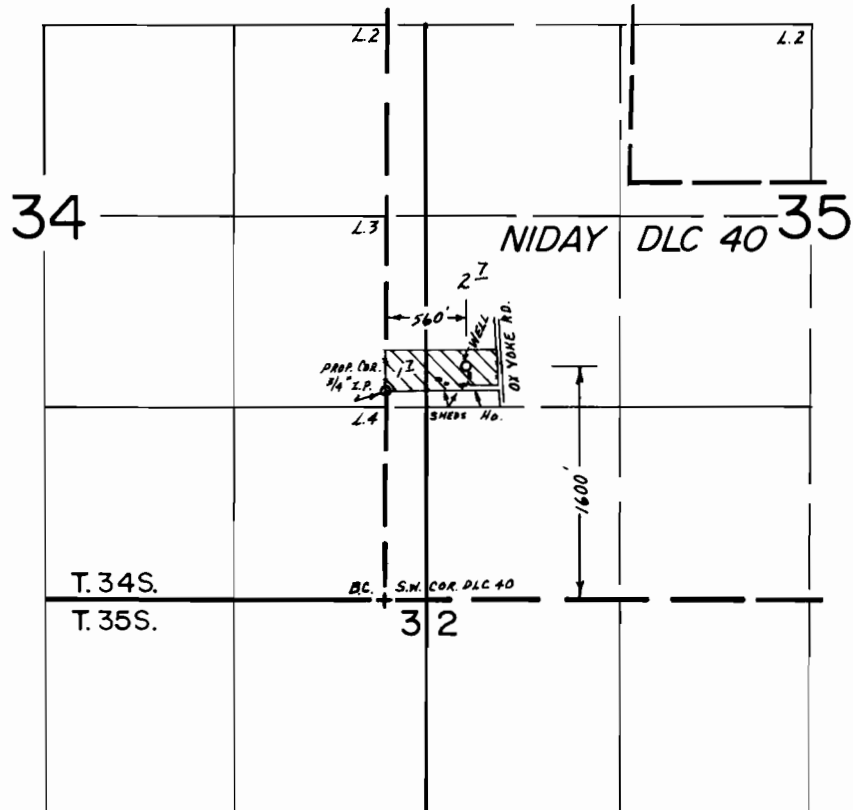

FINAL PROOF SURVEY
UNDER

Application No. G-7989 Permit No. G-7412.....
IN NAME OF

.....WILLIAM E. HUFF.....

Surveyed JUNE 26, 1978, by B.R. SUND.....