


T. 38 S., R. 7 W., W.M.

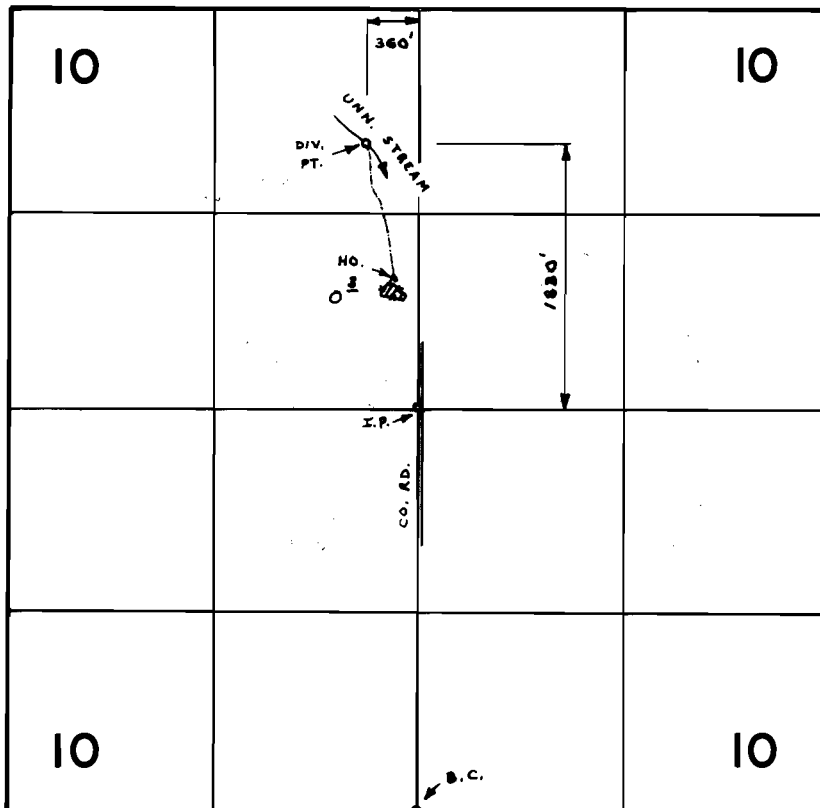

FINAL PROOF SURVEY
UNDER

Application No. 47379 Permit No. 35484
IN NAME OF

ROBERT RINZLER

Surveyed OCT. 30 1978, by B. SUND

D.H.M.
P.T.S. - 1978 - 14 - D