


T. 38 S., R. 6 W., W.M.

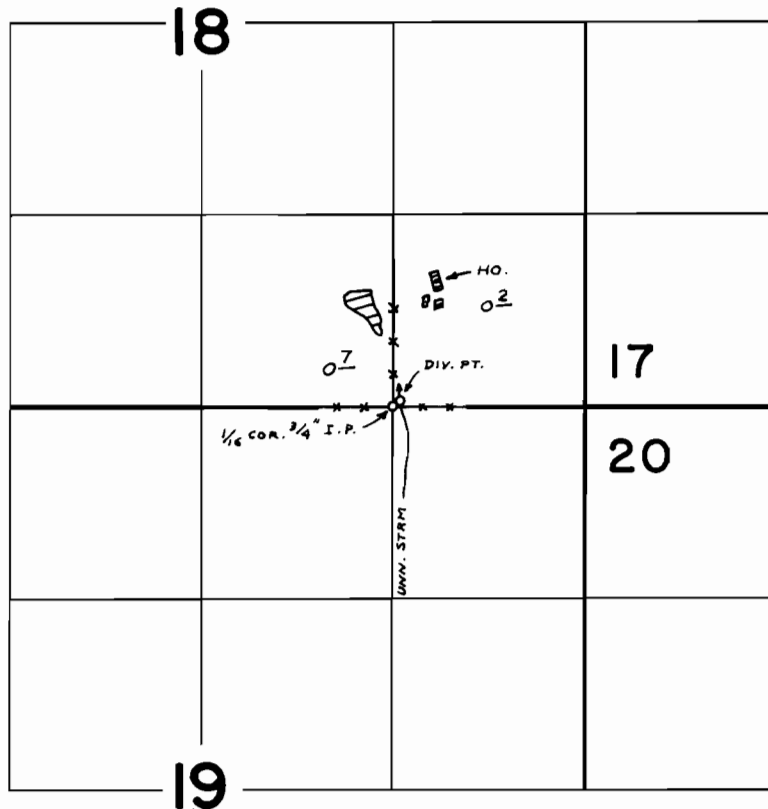

DIV. PT. LOC. - 40' N. & 50' E. FROM SW COR. SE1/4 SE1/4 SEC. 18.

FINAL PROOF SURVEY
UNDER

Application No. 49906 Permit No. 37555
IN NAME OF

HOBERT E. LANSDOWN

Surveyed JUL. 17 1978 by B. SUND