


T.36 S., R.5 W., W.M.

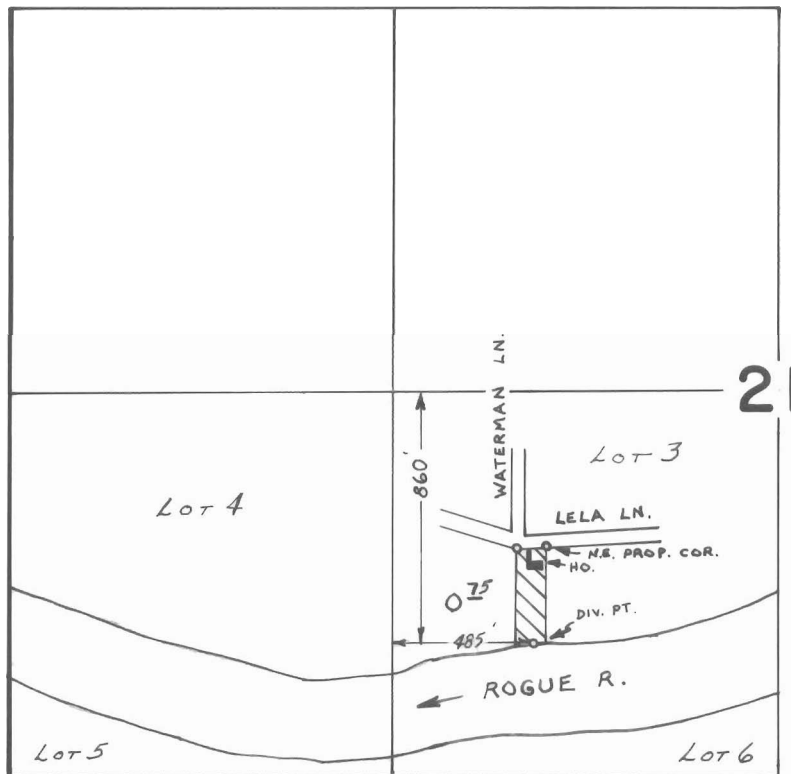

SCALE : 1" = 660 FT.

**FINAL PROOF SURVEY
UNDER**

Application No. 49561 Permit No. 41518
IN NAME OF

ARMAND L. OLSON

Surveyed JUN. 22 1978, by B. SUND

D.H.M.
P.T.S. - 1978-14-A