


T. 36 S., R. 6 W., W.M.

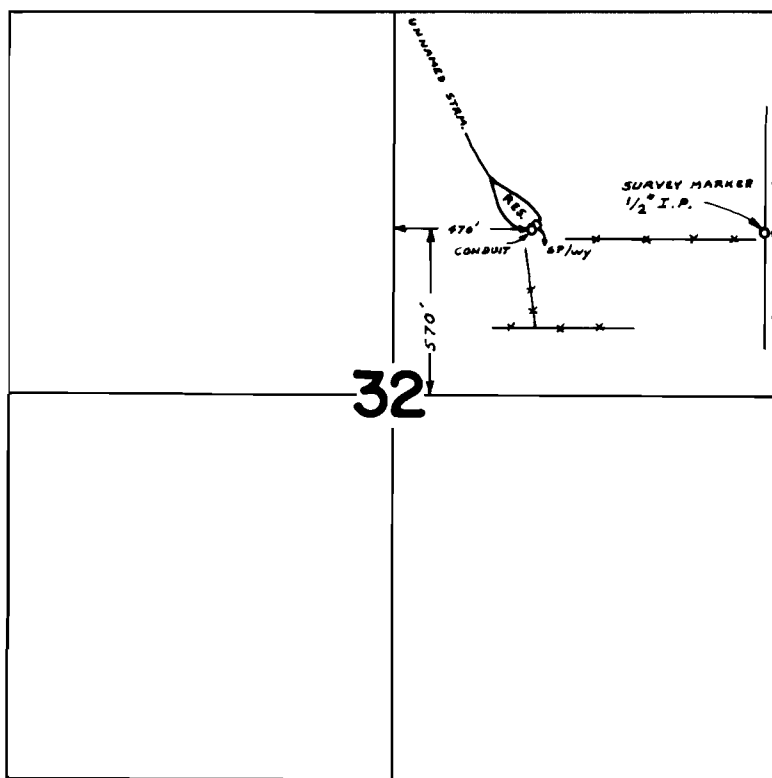

SCALE: 1" = 660 FT.

FINAL PROOF SURVEY UNDER

R-53330

R-7680

Application No. 57528 Permit No. 43346

IN NAME OF

LEO F. HOEBING

Surveyed NOV. 1 1978, by B. SUND