


T. 36 S., R. 6 W., W.M.

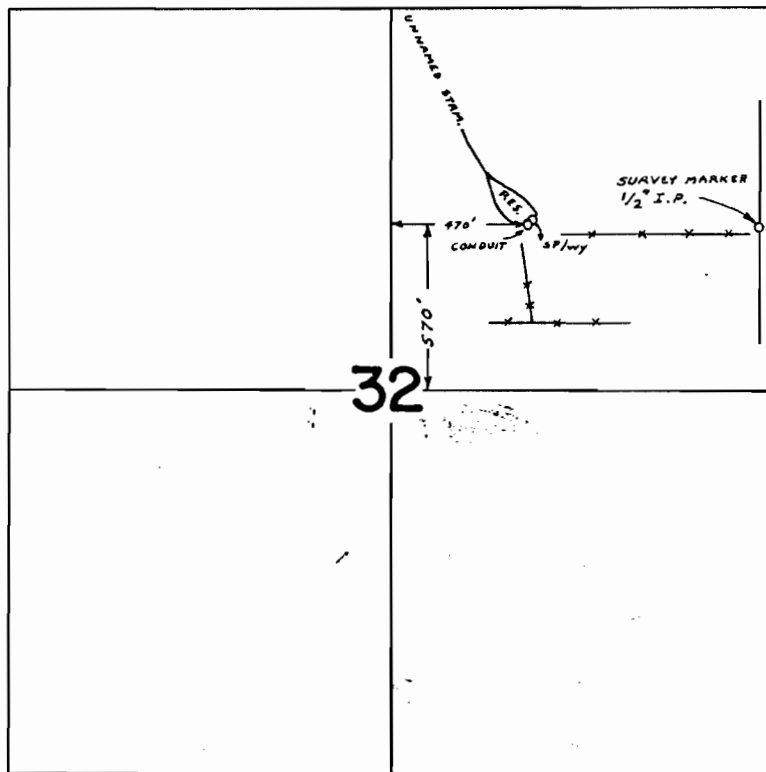

SCALE: 1" = 660 FT.

FINAL PROOF SURVEY
UNDER

Application No. R-53330 57528 Permit No. R-7680 43346

IN NAME OF

LEO F. HOEBING

Surveyed NOV. 1 1978, by B. SUND

P.T.S.-1978-14-D