


T5S. R6W. WM.

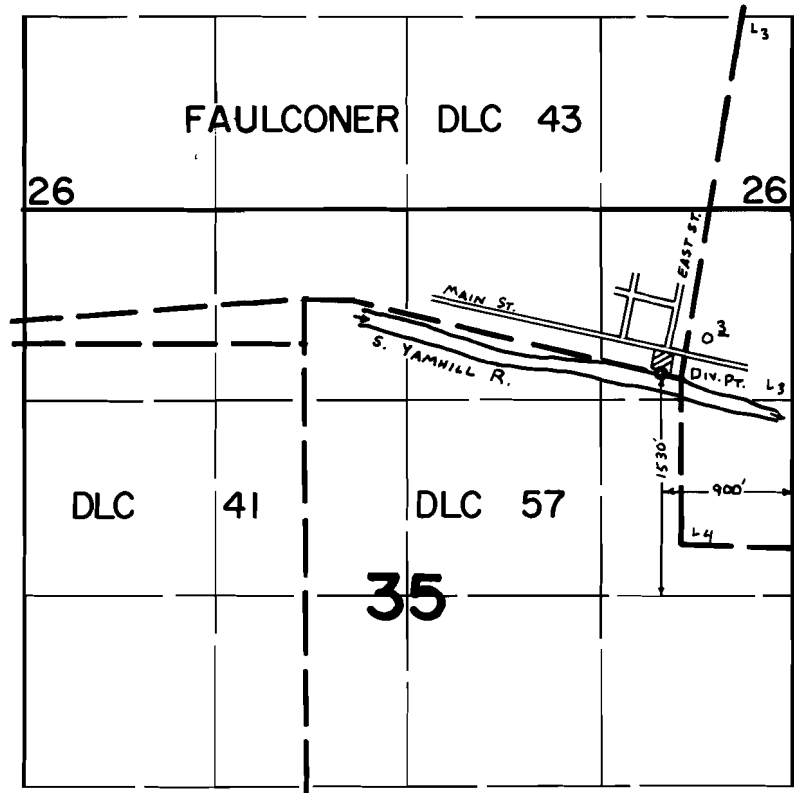

FINAL PROOF SURVEY UNDER

Application No. 53113 Permit No. 38593
IN NAME OF

FIRST CHRISTIAN CHURCH

Surveyed JULY 9 1976 by L. H. NUNN