


T3S. R3E. WM.

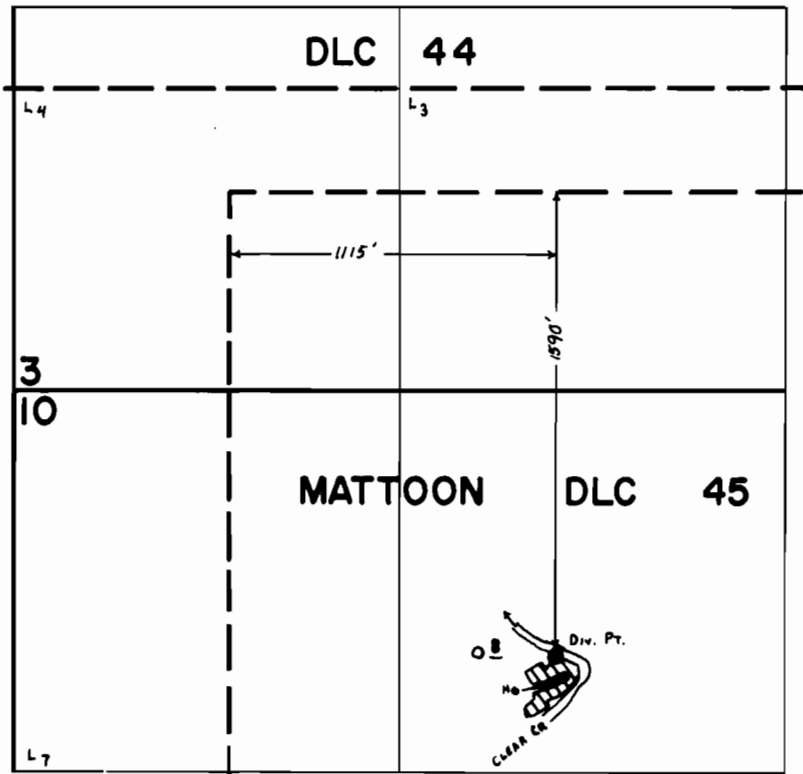

SCALE: 1 IN. = 10 CH. = 660 FT.

FINAL PROOF SURVEY UNDER

Application No. 53744 Permit No. 40361
IN NAME OF

PHILIP H. MILLER

Surveyed OCT. 12. 19.78, by C. L. HUGHES.