


T.5S. R.1E. W.M.

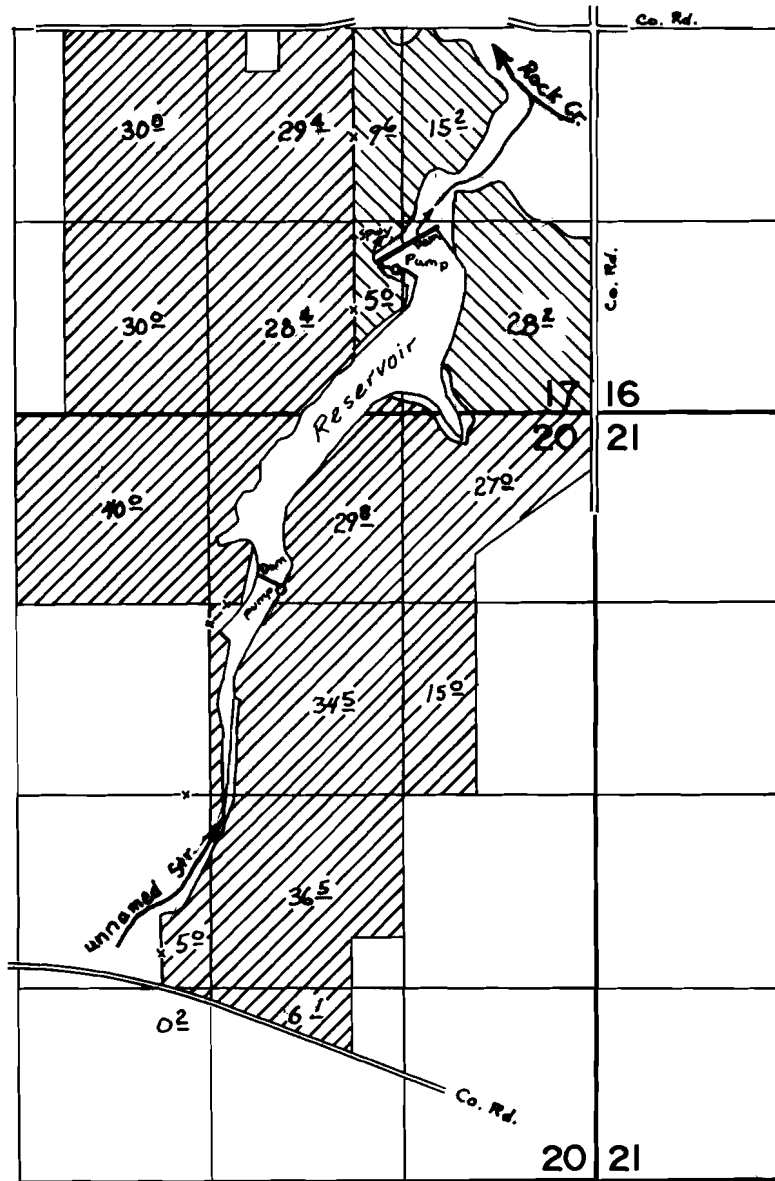

Dam Located 1220'N & 1220'W from the SE cor. Sec. 17

FINAL PROOF SURVEY UNDER

 Supplemental
 Primary

R-49300 R-5821
Application No. 49301 Permit No. 35975
IN NAME OF

BILL L. ROSE

Surveyed MAY 20, 1976, by L. E. GOULD