


# T.5S. R.1E. W.M.

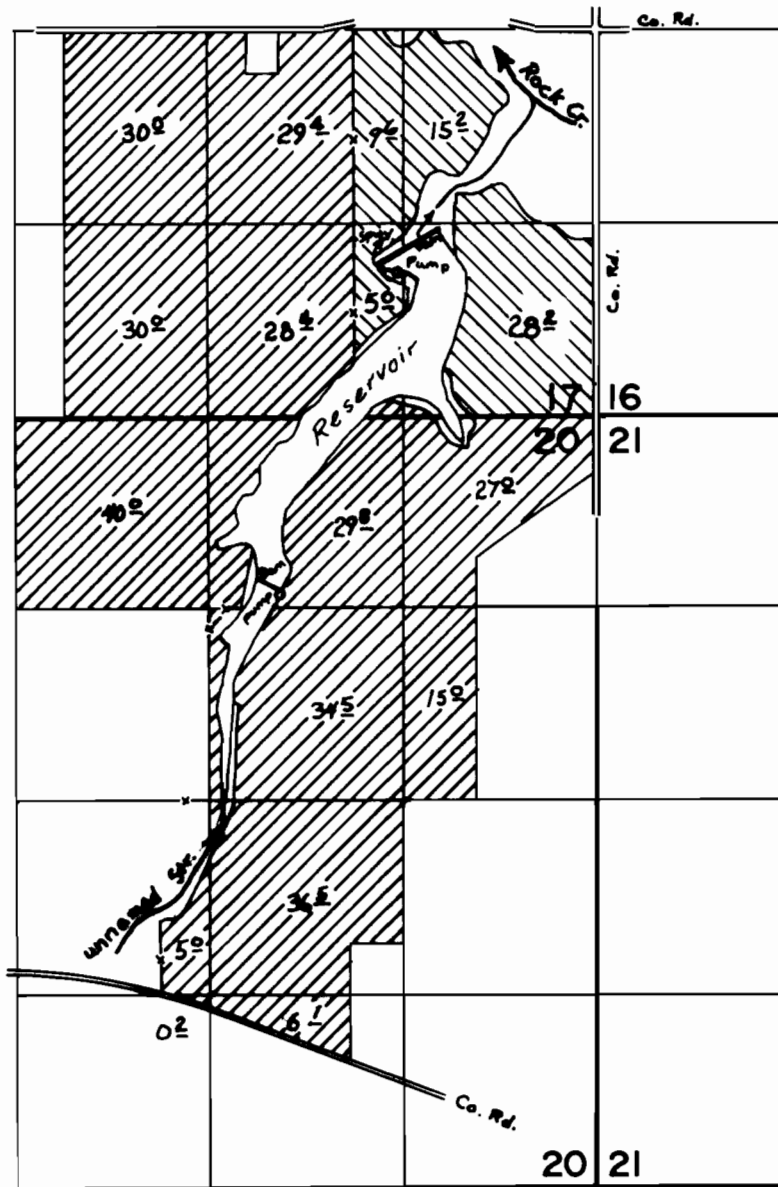

Dam Located 1220' N & 1220' W from the SE cor. Sec. 17

## FINAL PROOF SURVEY UNDER

 Supplemental  
 Primary

R-49300                      R-5821  
Application No. 49301... Permit No. 35975...  
IN NAME OF

BILL L. ROSE

Surveyed MAY 20, 1976, by L. E. GOULD