


T2S. R2E. WM.

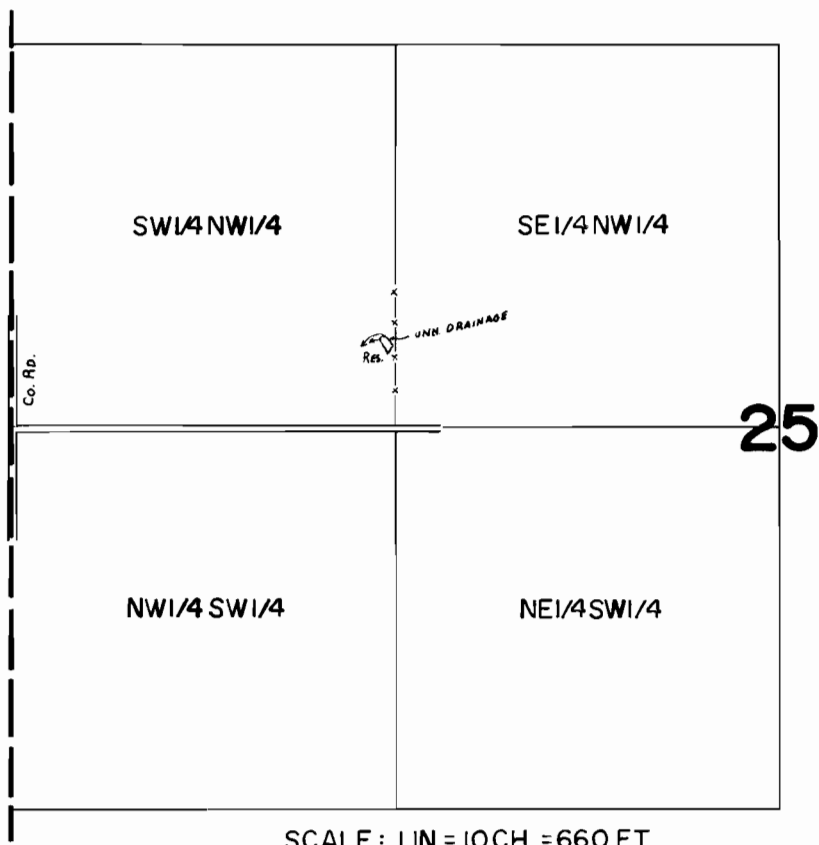

SCALE : 1 IN. = 10 CH. = 660 FT.

FINAL PROOF SURVEY
UNDER

Application No. R-51882 Permit No. R-6073
IN NAME OF

EDWARD A. FIEN

Surveyed SEPT 28 1978, by C. L. HUGHES