


T2S.R4E.WM.

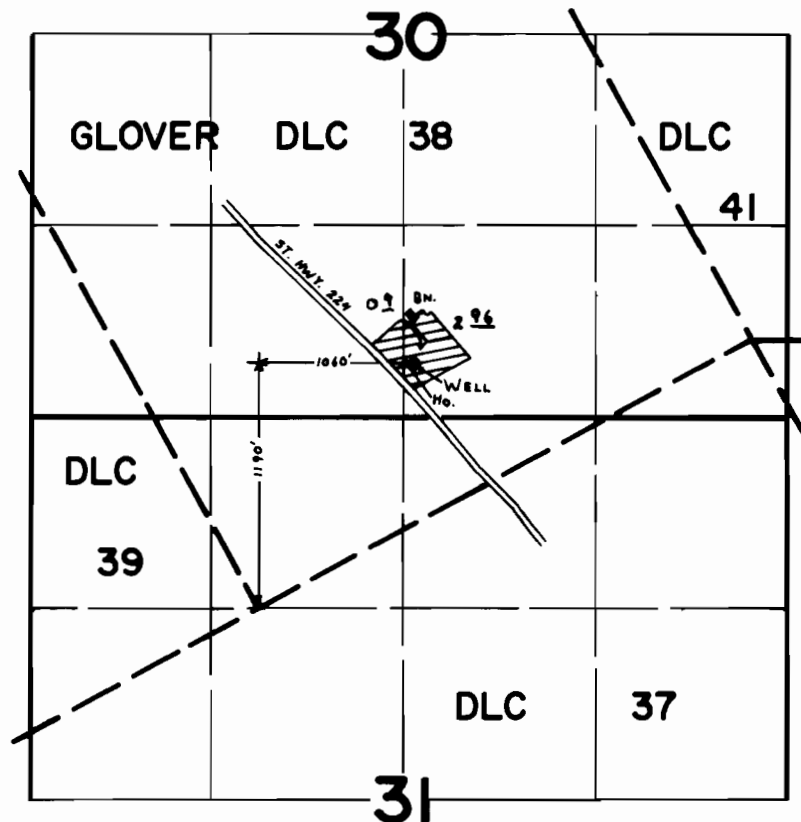

FINAL PROOF SURVEY

UNDER

Application No. G-6178 Permit No. G-5241
IN NAME OF _____

CLIFTON, JR. & MIRIAM E. GLOVER

Surveyed JULY 10 1978, by C. L. HUGHES