


# T.2S. R.2E. W.M.

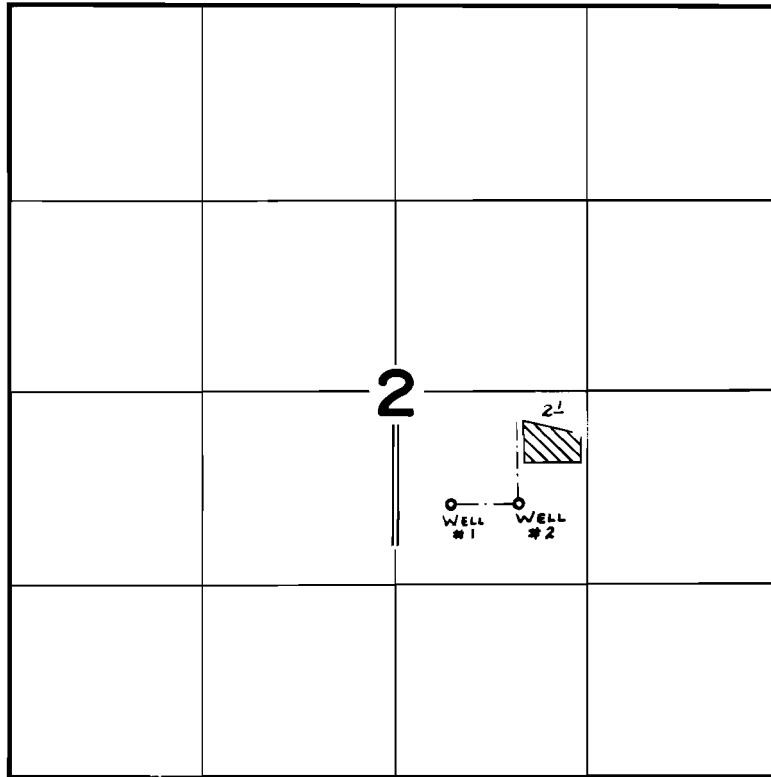

WELLS LOC : #1- 770' S. { 370' E. } BOTH fr. C. & COR. SEC. 2.  
              #2- 770' S. { 850' E. }

## FINAL PROOF SURVEY UNDER

Application No. G-7413 Permit No. G-6917  
IN NAME OF

RHODODENDRON NURSERY INC.

Surveyed OCT. 3 1978, by C. L. HUGHES