


T.2 S. R.4 E. W.M.

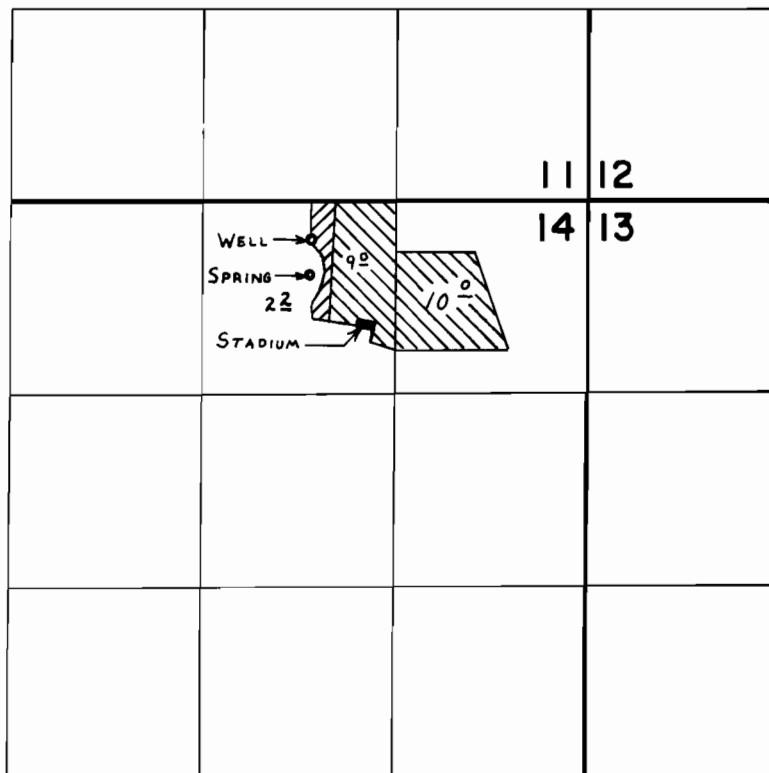

DIV. PTS. LOCATED: WELL, 270'S. & 1890'W. FROM N.E. COR. SECTION 14.

- ▨ - PRIMARY fr. WELL
- ▨ - PRIMARY fr. SPRING; SUPPLEMENTAL fr. WELL

FINAL PROOF SURVEY UNDER

Application No. G-7661 Permit No. G-7151
IN NAME OF

SANDY UNION HIGH SCHOOL DIST. NO. 2

Surveyed OCT. 11, 1978, by C. L. HUGHES