


TIS. R4E. WM.

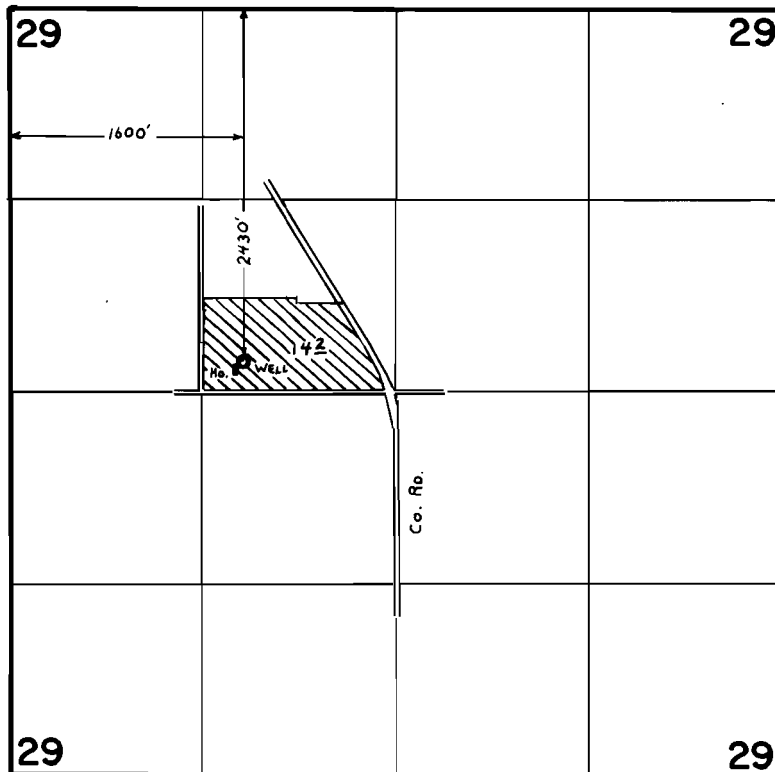

FINAL PROOF SURVEY
UNDER

Application No. G-7941 Permit No. G-7325
IN NAME OF

DAN LEWIS NELSON

Surveyed JULY 11 1978, by C. L. HUGHES