


285
T.29S, R.14 W.W.M.

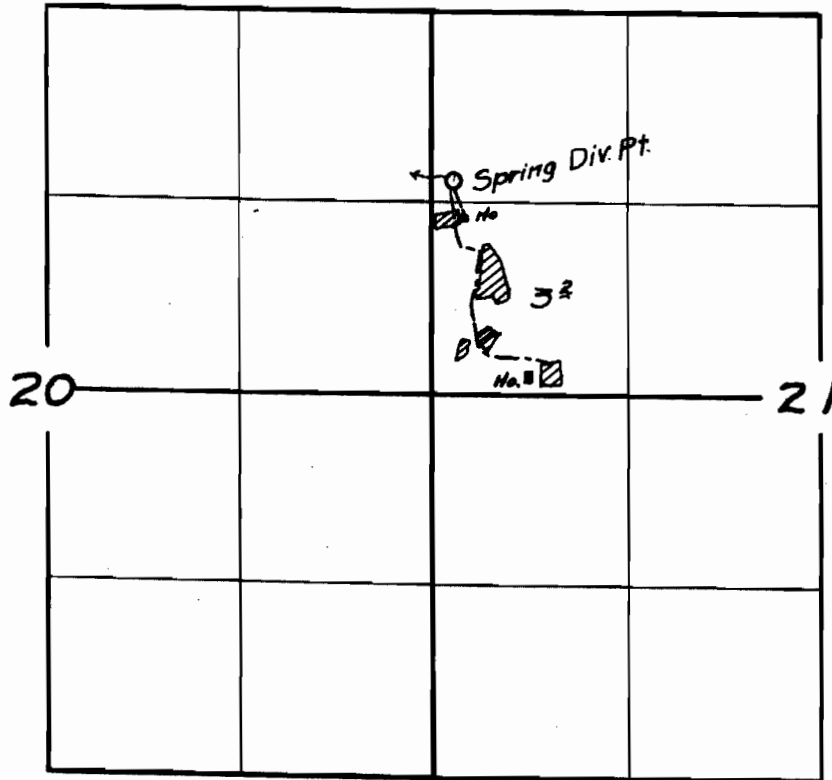

FINAL PROOF SURVEY

UNDER

Application No. 18377 Permit No. 14019

IN NAME OF

W. J. & ROWENA PULLEN

Surveyed 18. March. 1955, by H. L. Coffman