


T.29S. R.15W. W.M.

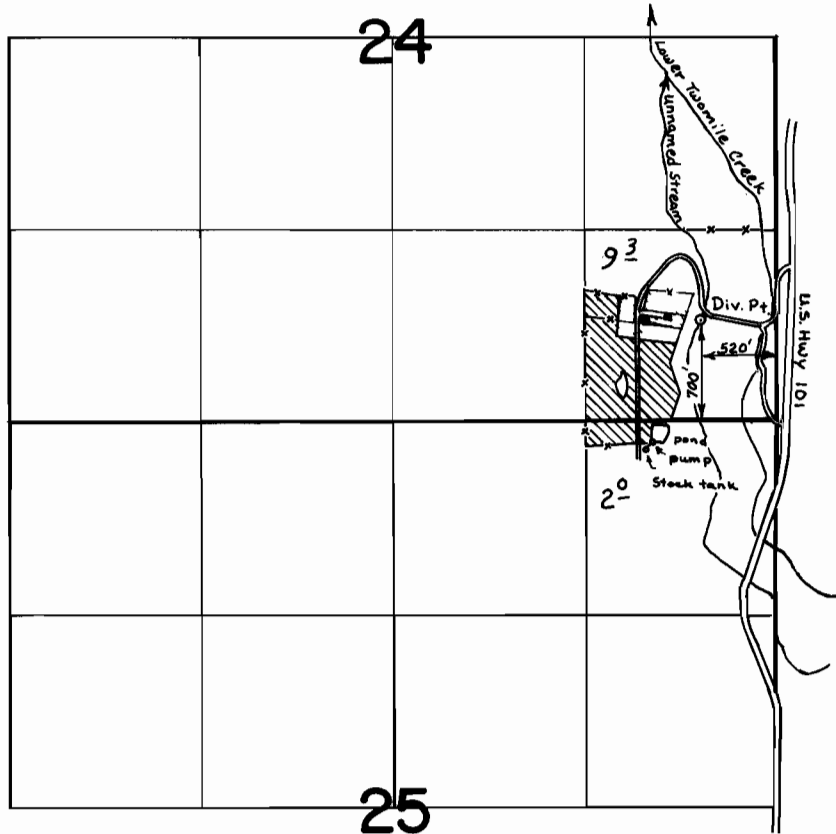

SCALE: 4" = 1 mile

**FINAL PROOF SURVEY**  
UNDER

Application No. 55594 Permit No. 41660  
IN NAME OF

Reinhard and Carol Schoepel

Surveyed July.10... 1980., by S.Donaldson.....