


T. 24 S. R. 13 W. W.M.

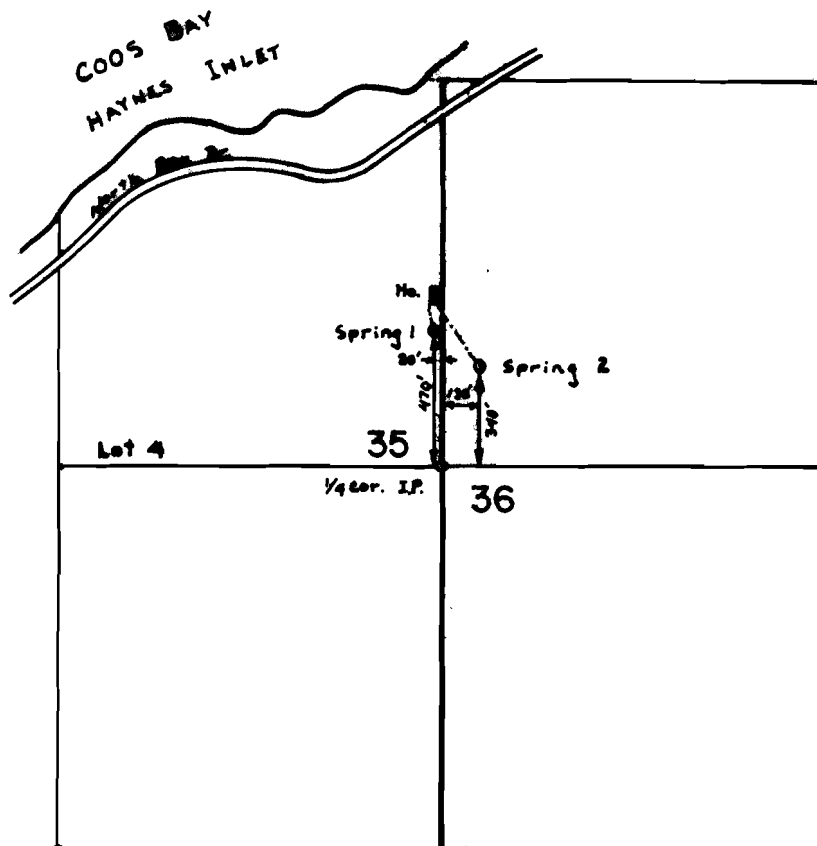

SCALE: 1" = 660'

**FINAL PROOF SURVEY**  
UNDER

Application No. 55801 Permit No. 41778  
IN NAME OF

CLIFFORD H. & LILA B. INMAN

Surveyed April 18, 1978, by D. Sparks