


T.13S. R.15E. W.M.

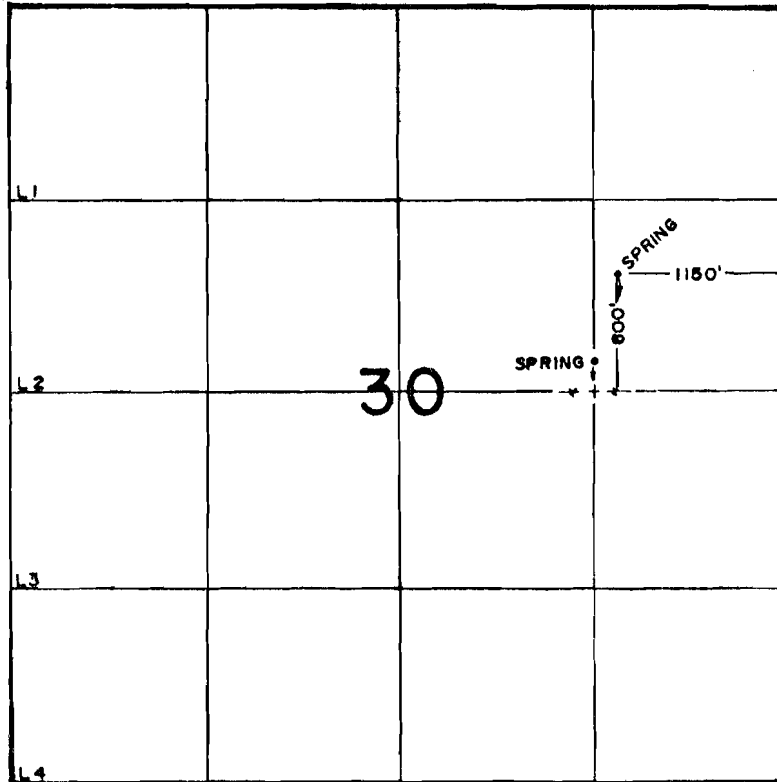

FINAL PROOF SURVEY
UNDER

Application No. 55153..... Permit No. 41344.....
IN NAME OF

BOBBY & SHARON GATLIN

Surveyed MAR. 5... 1981... by L.H. NUNN.....

cert 50475

41344