


1492

50488

1803

T.10-S.R.34E.W.M.

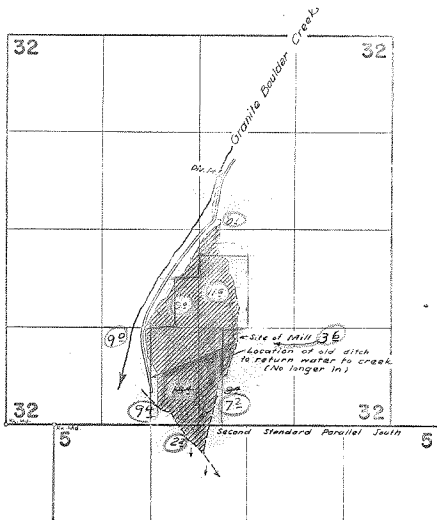

# FINAL PROOF SURVEY UNDER

POWER CLAIM 270

Application No. 2794 Permit No. 1492  
IN NAME OF

OXBOW RANCH

Surveyed August 23 1961, by L. J. Jackson