


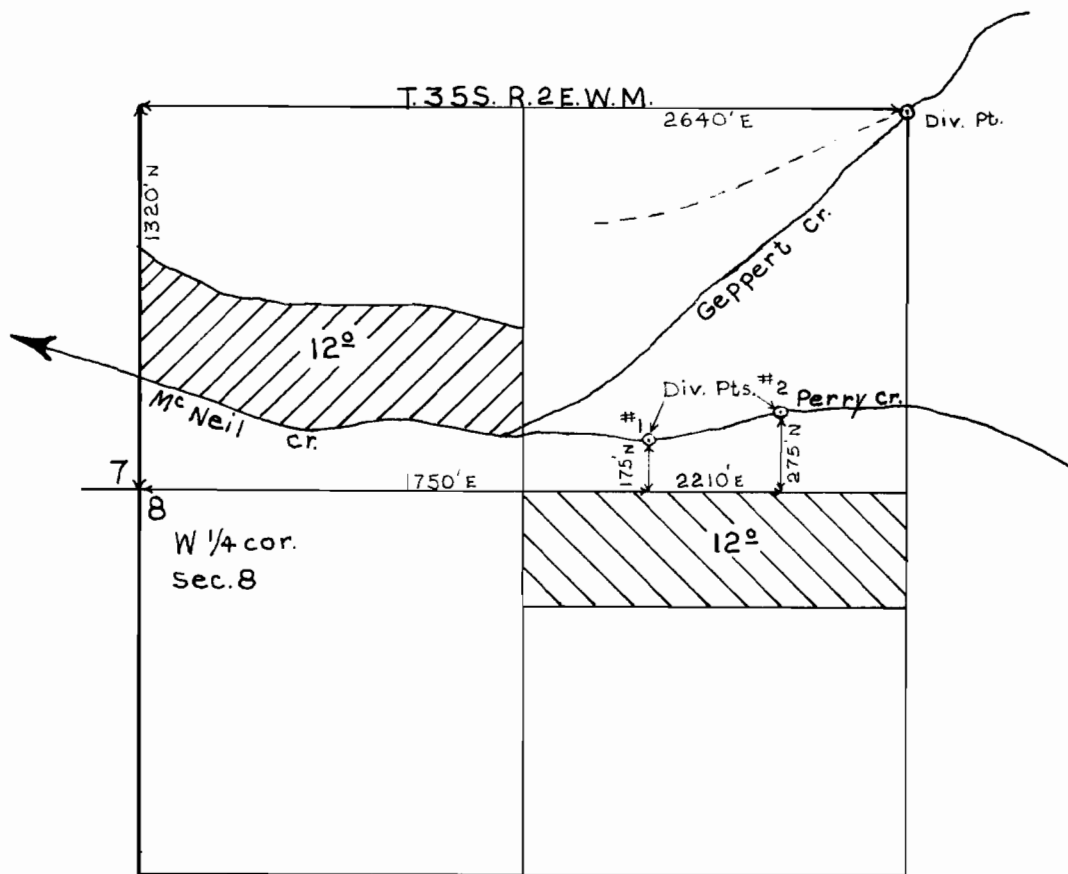

-  Present Place of use
-  Proposed Place of use

Map for Blanche O. Campbell for a
change in place of use



Scale 8" = 1 Mile