


T.35S. R.2W.W.M.

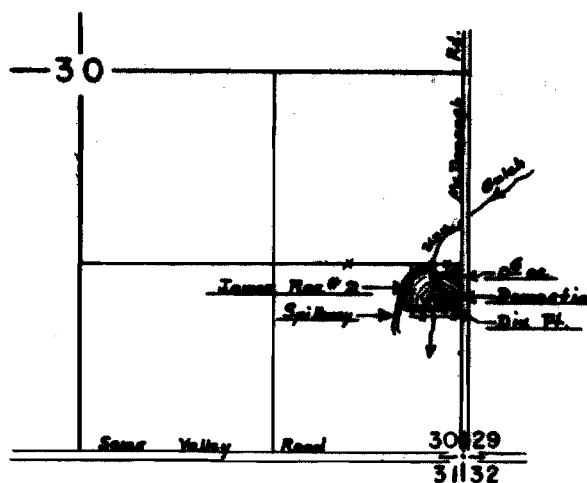

Div. Pt. (Dam) is located 1020' N. of
220' W. from S.E. Cor. Sec. 30.

**FINAL PROOF SURVEY
UNDER**

R-42074 R-4797
Application No. 42075..... Permit No. 31596.....
IN NAME OF

Mark & Kay Goeres

Surveyed 6-5-..... 1975, by D. L. Hendrix
Inspection 7-24-80 by B. R. Sund