


T. 35S., R. 6 W., W.M.

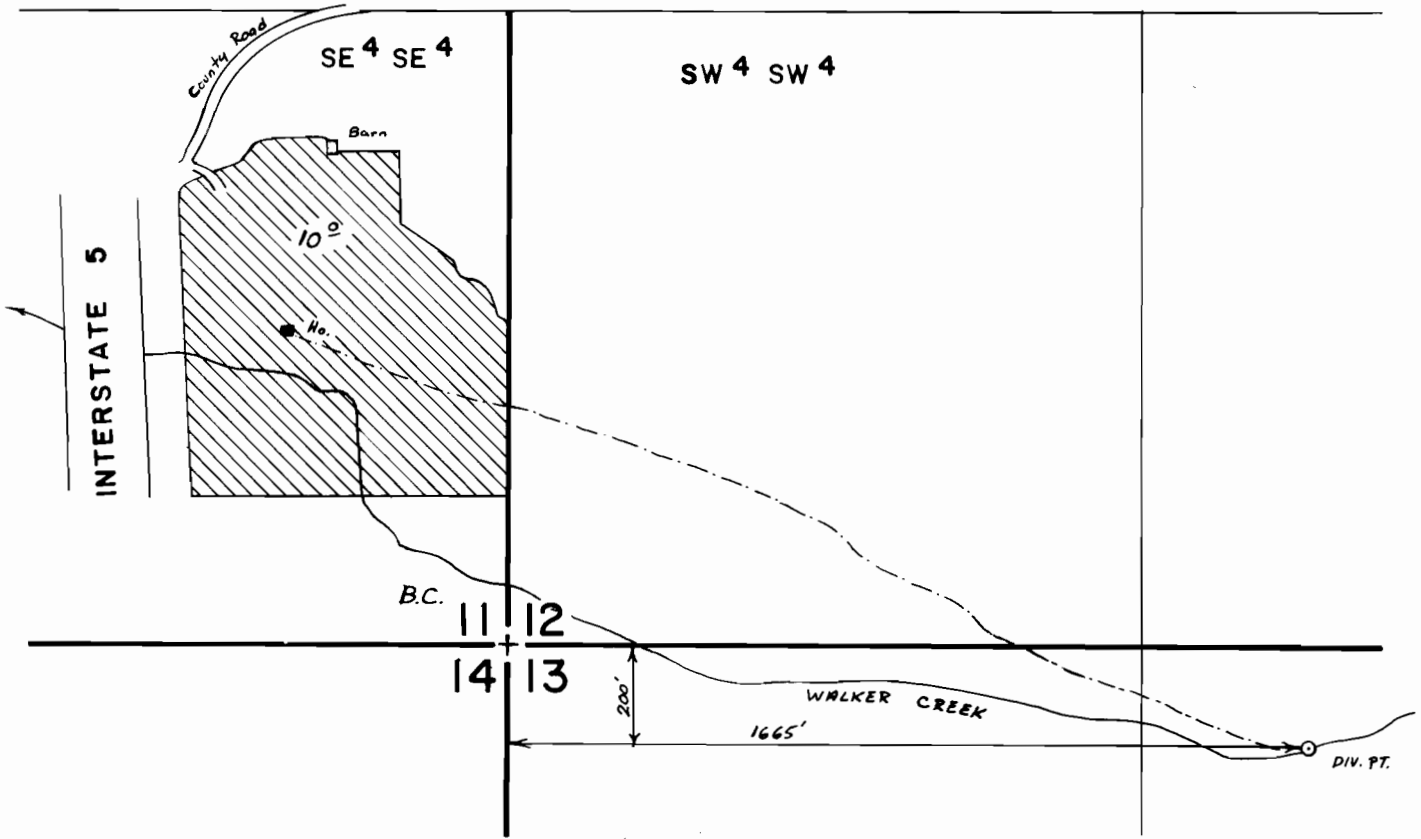

FINAL PROOF SURVEY

FOR CORRECTION OF

CERTIFICATE No. 1844

Application No. Permit No.

IN NAME OF

C. F. FOSS

Surveyed Feb..12., 1981., by Bruce..R..Sund..