


T. 36 S. R. 12 E. W. M.

Sycam Rv. to be Sycam Marsh well

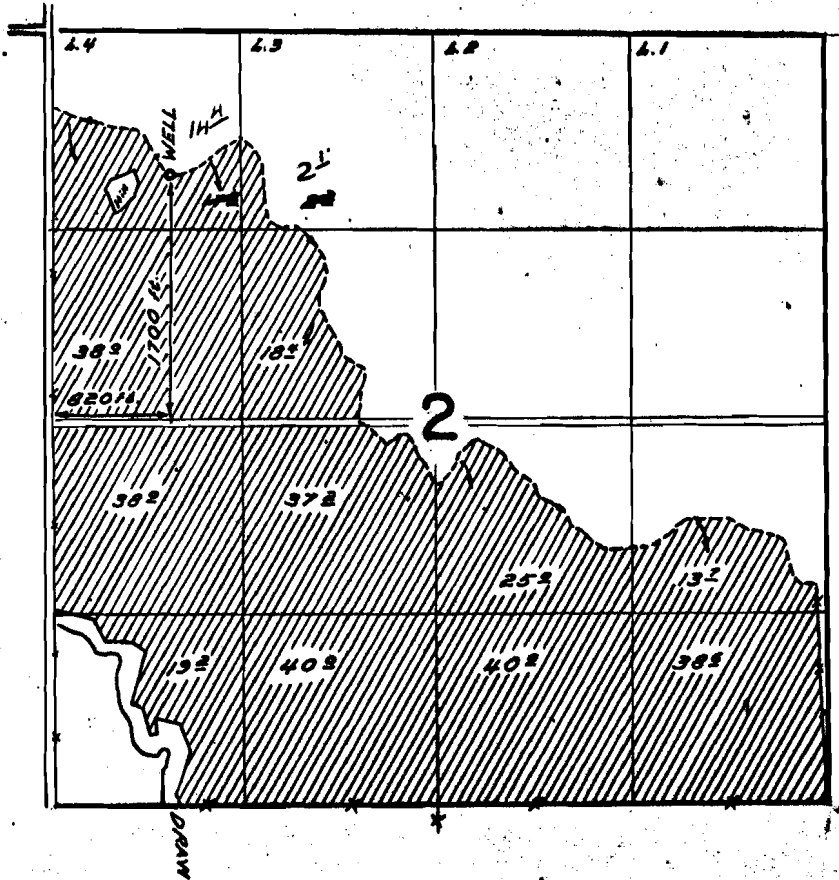

FINAL PROOF SURVEY UNDER

Application No. G-2580 Permit No. G-2392
IN NAME OF

L. L. Crawford

Surveyed Oct. 13 1966, by M. J. Ruppert