




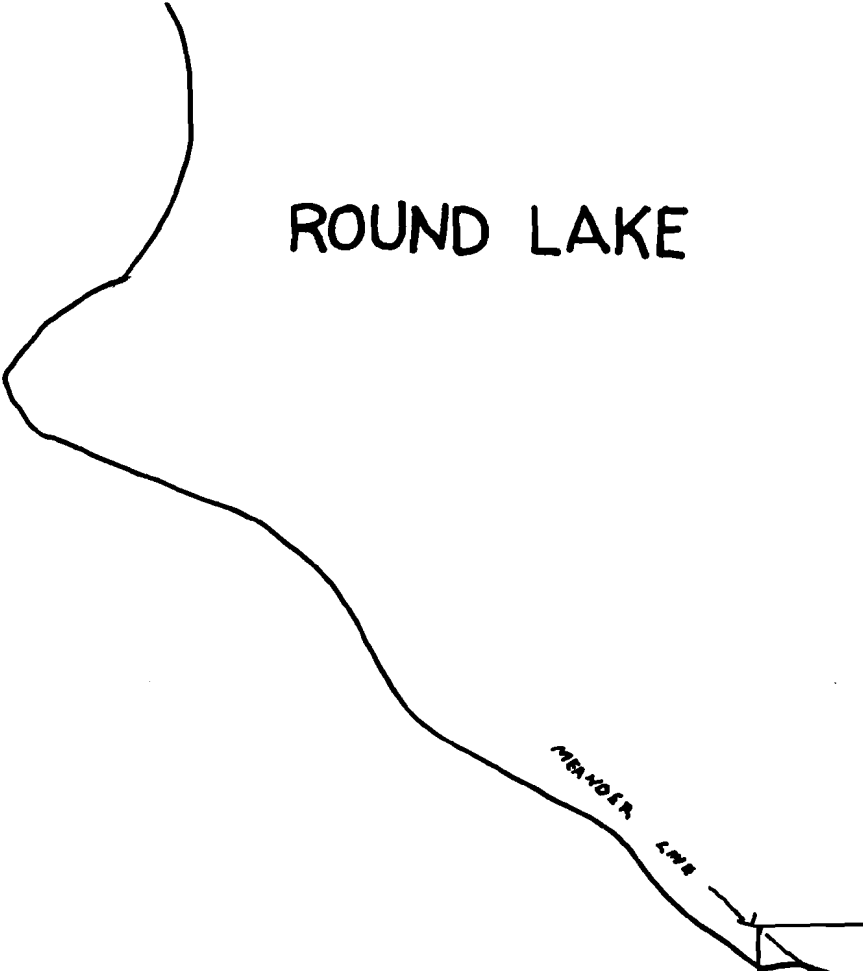


DE: #1 - 1250' N. & 180' W FROM SE COR. SEC. 6
 #2 - 320' N. & 900' W FROM NW COR. SEC. 6
 #3 - 1030' S & 10' W FROM E 1/4 COR. SEC. 7

G-2907 Part Cont. H.S.


ROUND LAKE



- WELL#1 →  SUPPLEMENTAL
- WELL#2 →  SUPPLEMENTAL
- WELL#3 →  SUPPLEMENTAL
- ↓  PRIMARY

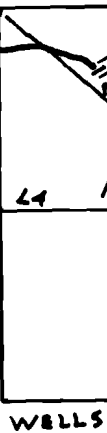

WELLS

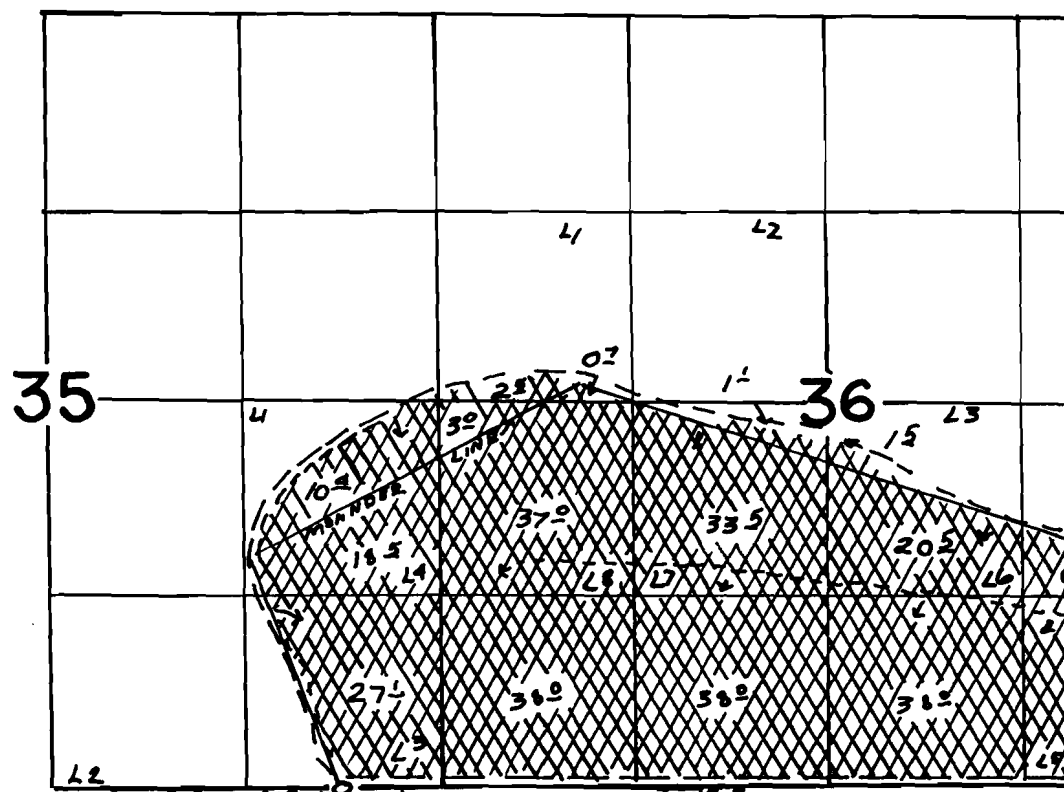

ROUND LAKE


