



T. 27 S. R. 18 & 19 E. W.M.

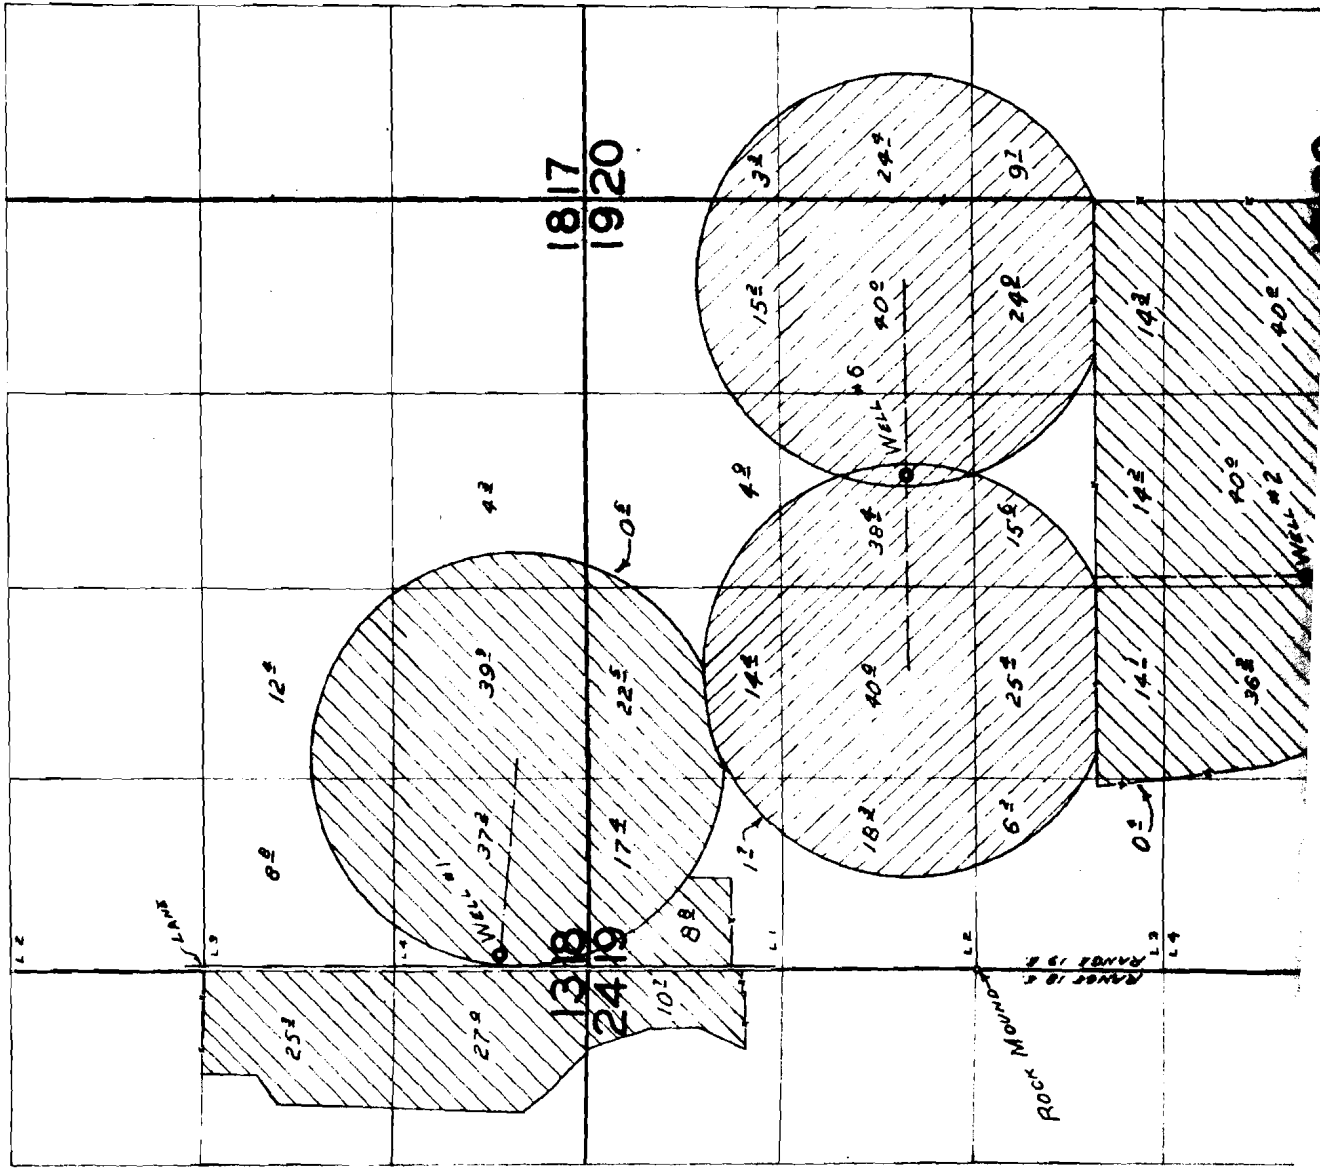

2530

29

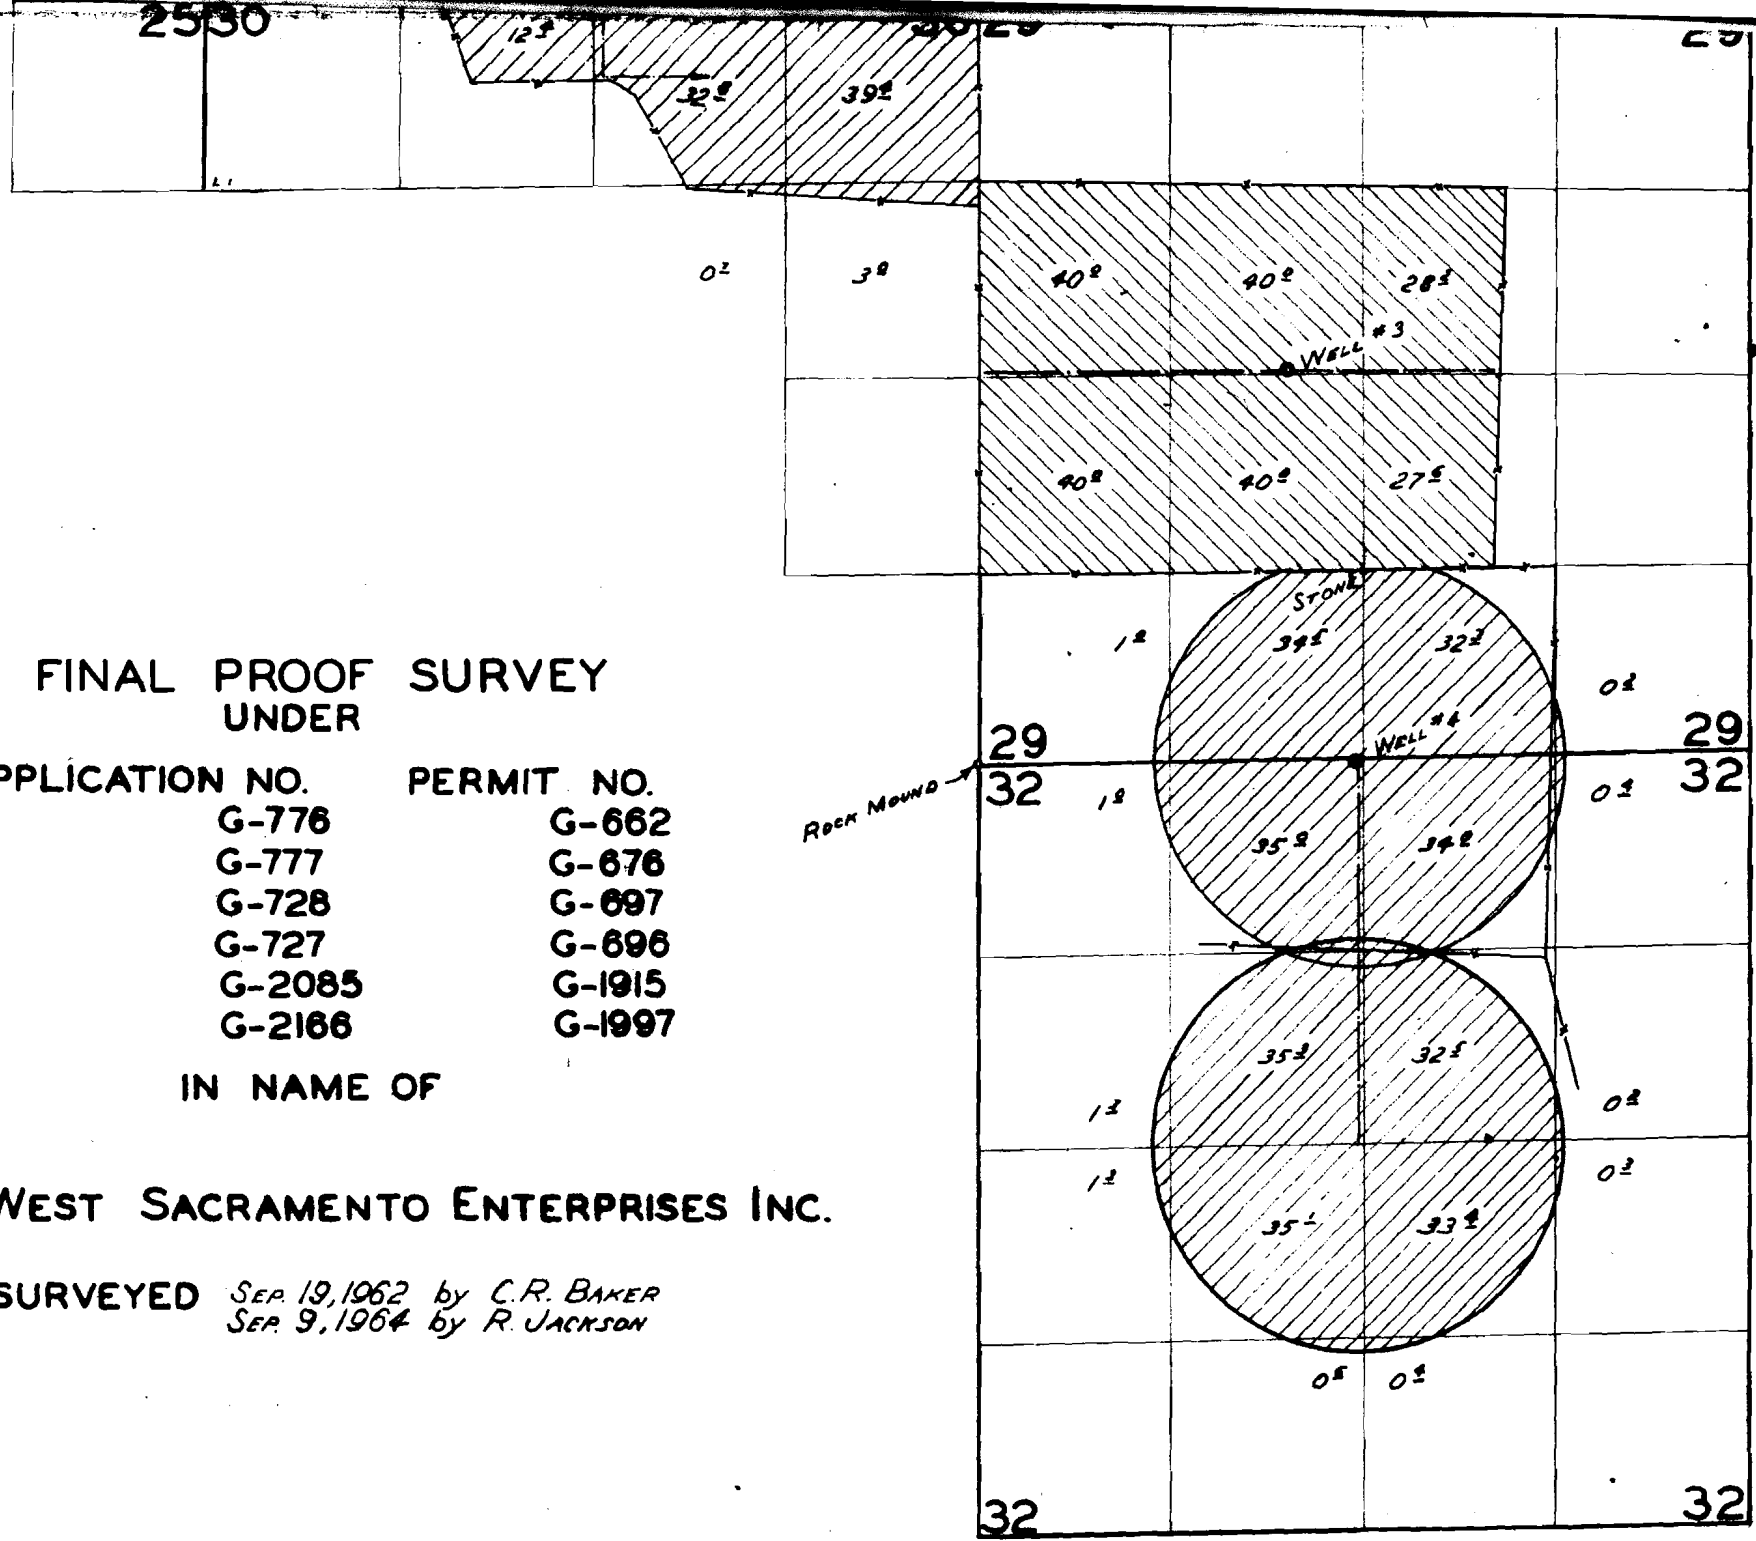

**FINAL PROOF SURVEY  
UNDER**

<b>APPLICATION NO.</b>	<b>PERMIT NO.</b>
G-776	G-662
G-777	G-676
G-728	G-697
G-727	G-696
G-2085	G-1915
G-2166	G-1997

**IN NAME OF**

**WEST SACRAMENTO ENTERPRISES INC.**

**SURVEYED** SEP. 19, 1962 by C.R. BAKER  
SEP. 9, 1964 by R. JACKSON