


T.19S. R.1W. W.M.

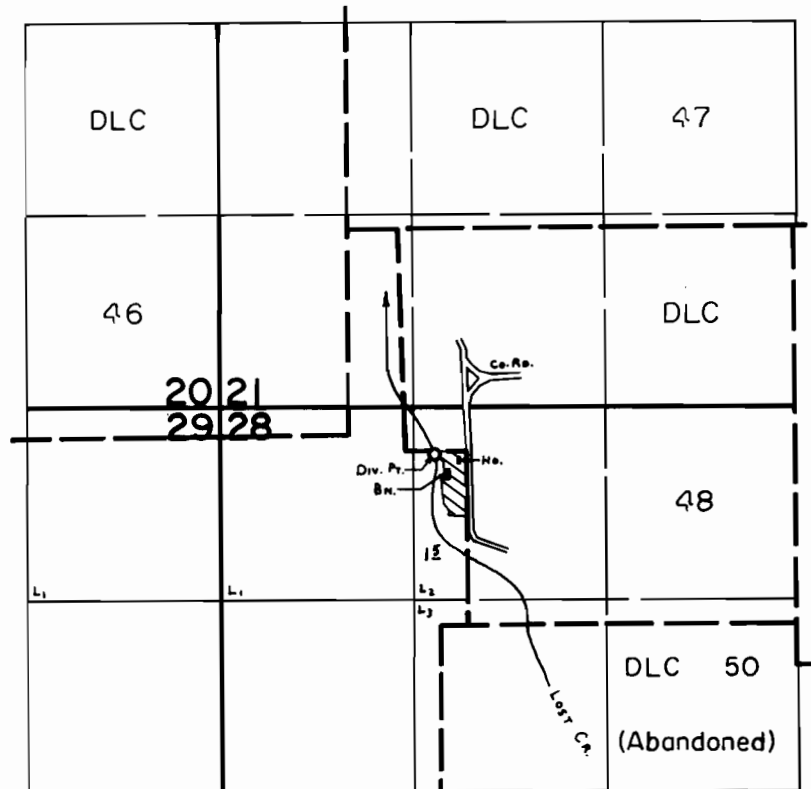

DIV. PT. LOC: 20'S. & 220' W. FR. W. INT. ELL. COR. HUNSACKER D.L.C. 48.

FINAL PROOF SURVEY UNDER

Application No. 52987.. Permit No. 39995.....
IN NAME OF

Benjamin J. & Judy K. Constant.....

Surveyed May 25, 1979, by G. L. HUGHES..