


TIBS. RIOW. WM.

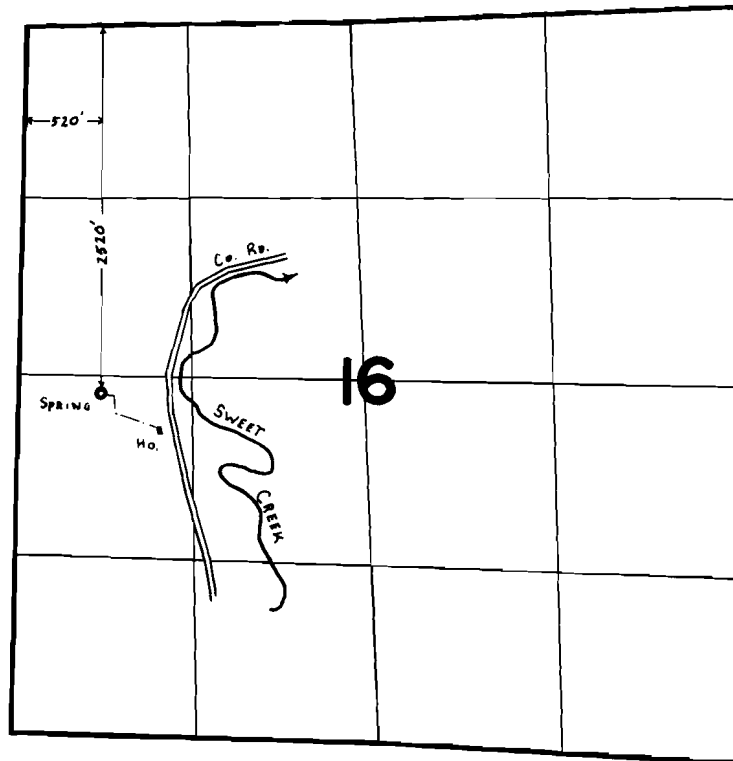

FINAL PROOF SURVEY UNDER

Application No. 55723 Permit No. 41736
IN NAME OF

HARRY TIMBERLAKE

Surveyed JULY 25 1978, by C. L. HUGHES