

RESERVOIR AND WATER RIGHT PLAT

SECTION 22, 23, T11S, R8W

LINCOLN CO. ORE.

RECEIVED
JAN 7 1971

STATE ENGINEER
SALEM, OREGON


Scale 1" = 100'

1-4-71

Contour interval, 1'

RECEIVED
MAY 4 1971

STATE ENGINEER
SALEM, OREGON

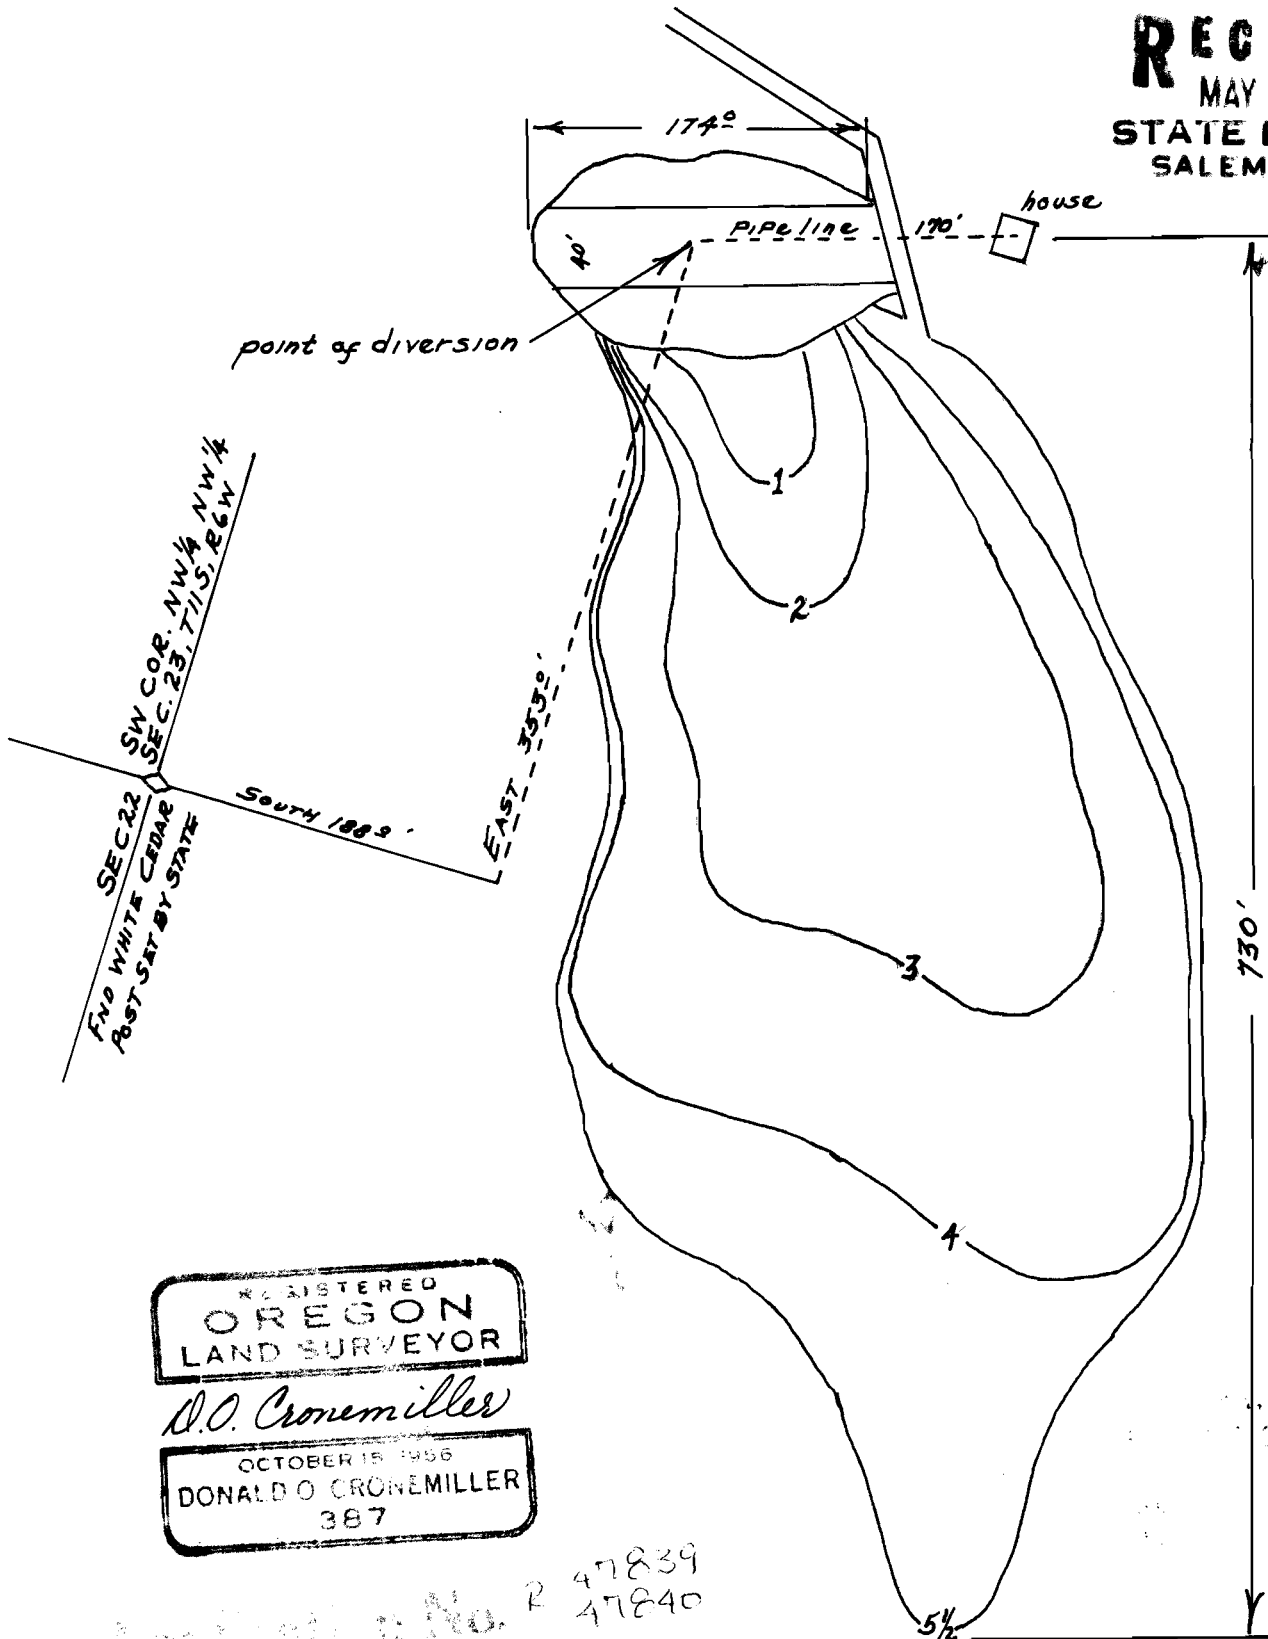

REGISTERED
OREGON
LAND SURVEYOR

D.O. Cronemiller

OCTOBER 15 1956
DONALD O. CRONEMILLER
387

47840
1-4-71
5767

WATER RESOURCES DEPT
SALEM, OREGON


Contour interval, 1'

STATE ENGINEER
SALEM, OREGON

1-4-71

Area in question

STATE ENGINEER
SALEM, OREGON

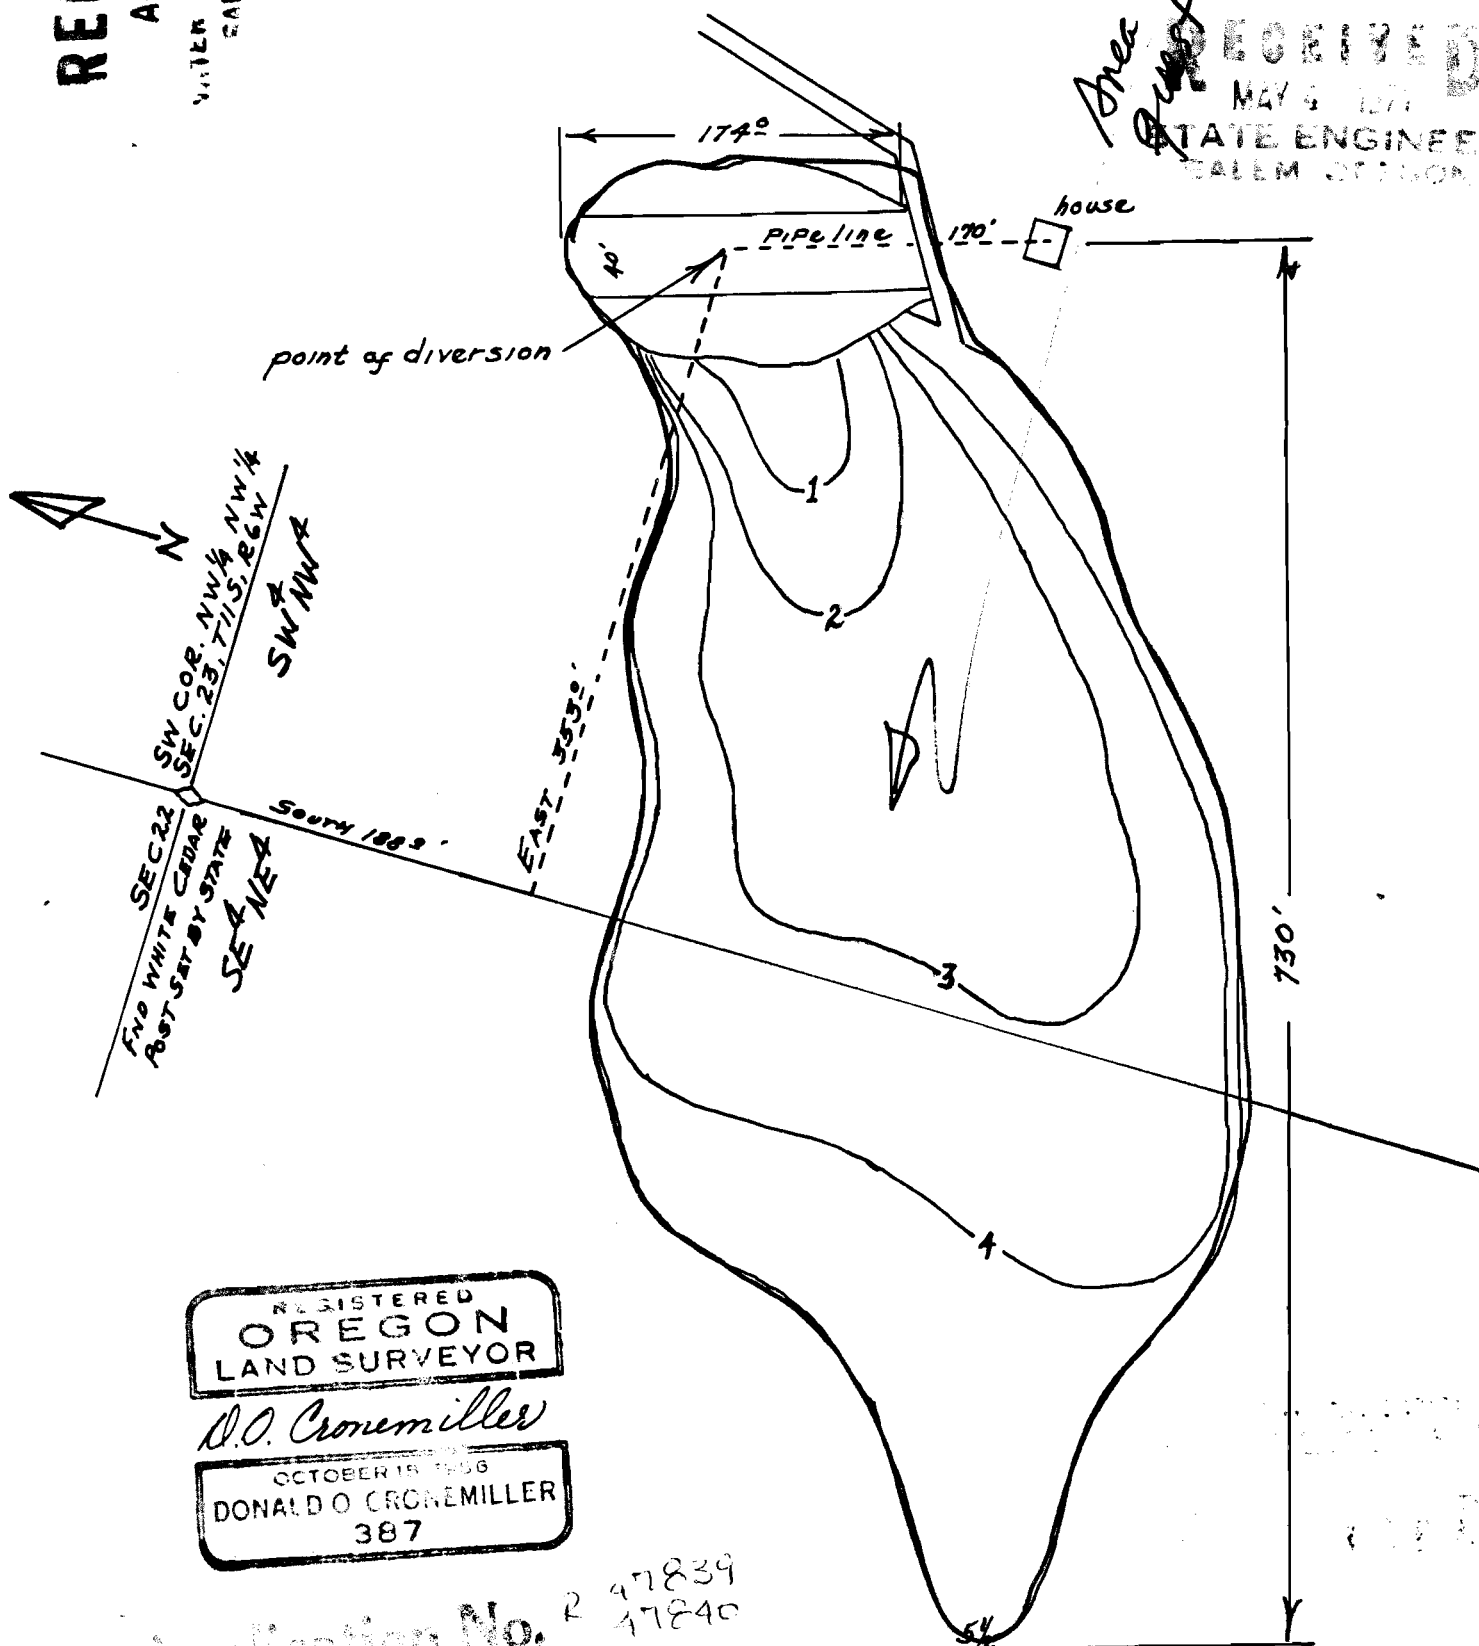

OCTOBER 15 1956
DONALD O CROEMILLER
387

Application No. 2 47839
