

RESERVOIR AND WATER RIGHT PLAT

SECTION 22, 23, T11S, R8W

LINCOLN CO. ORE.

RECEIVED
JAN 7 1971

STATE ENGINEER
SALEM, OREGON


Scale 1" = 100'

1-4-71

Contour interval, 1'

RECEIVED
MAY 4 1971

STATE ENGINEER
SALEM, OREGON

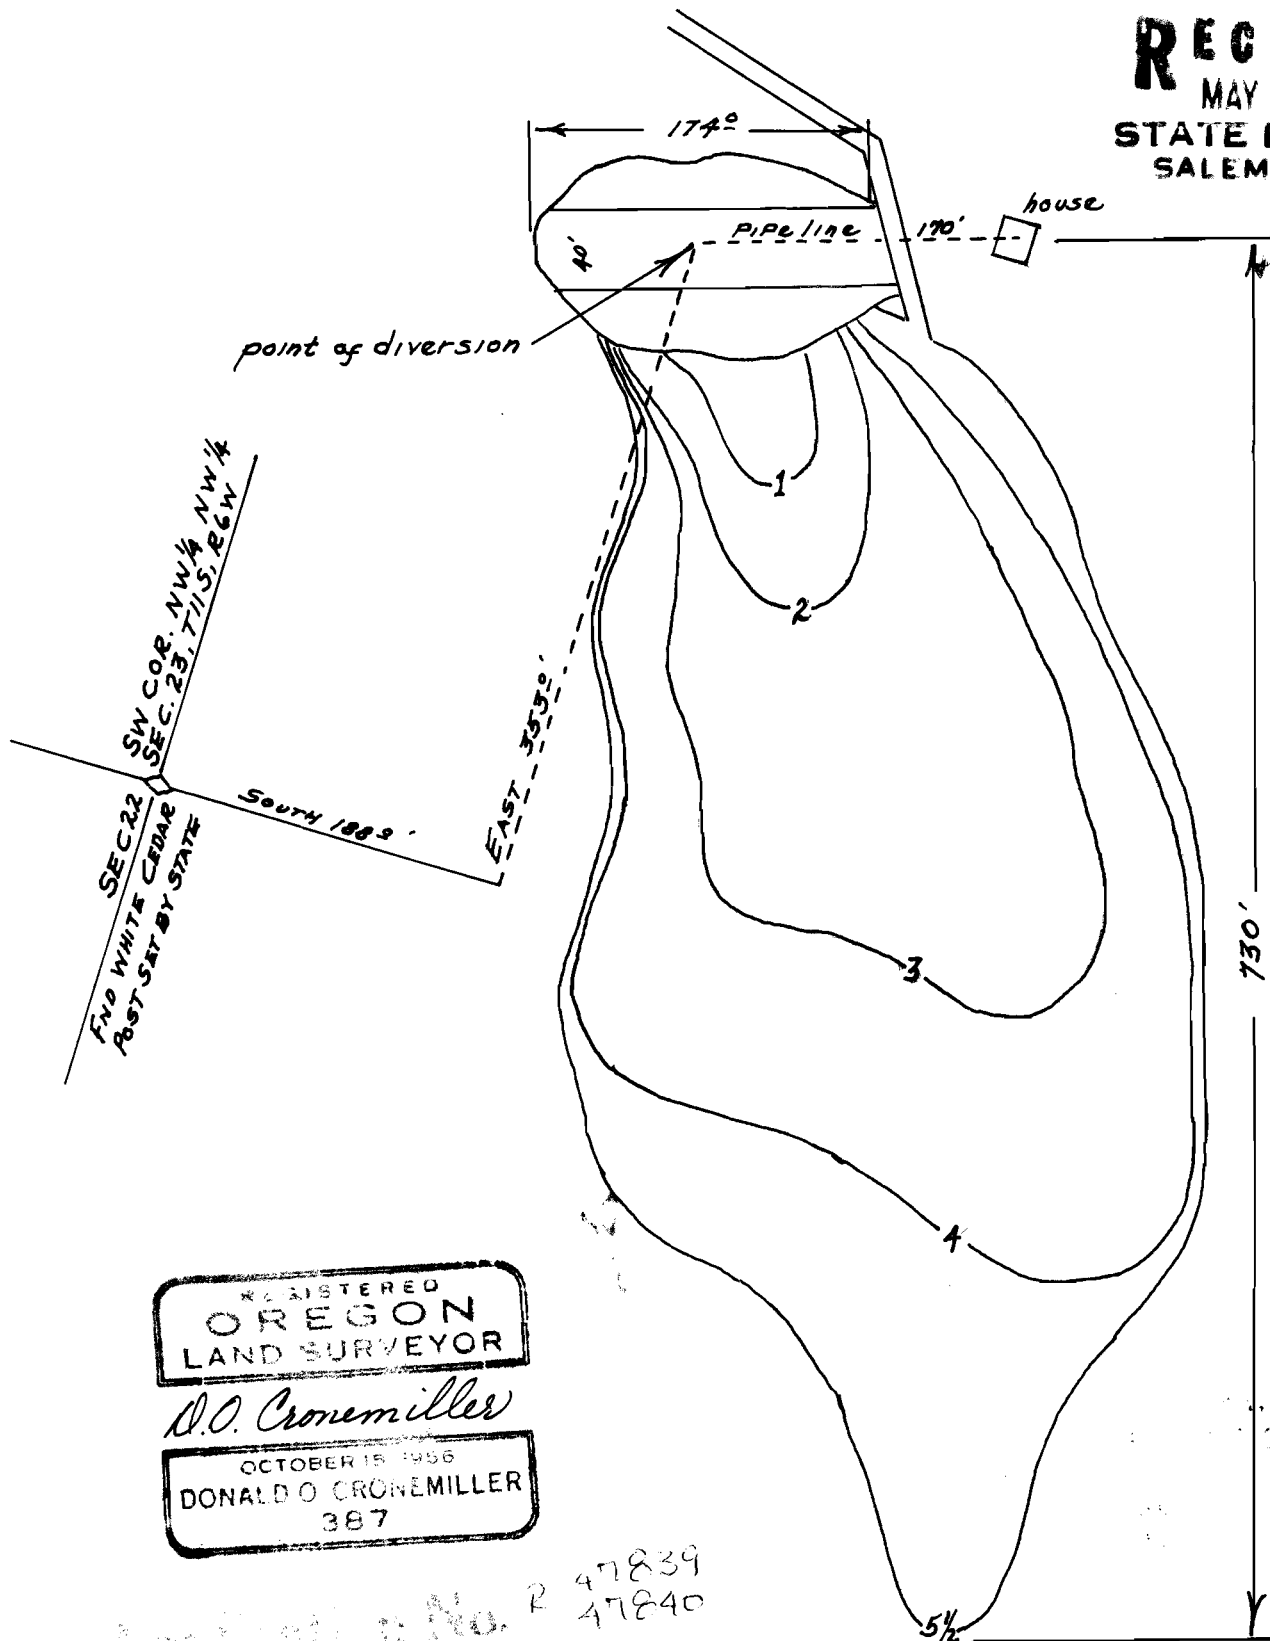

REGISTERED
OREGON
LAND SURVEYOR

D.O. Cronemiller

OCTOBER 15 1956
DONALD O. CRONEMILLER
387


RECEIVED

AUG 12 1980

WATER RESOURCES DEPT
SALEM, OREGON

SECTION 22, 23, T11S, R8W

LINCOLN CO. ORE.

Scale 1" = 100'

Contour interval, 1'

RECEIVED

JAN 7 1971

STATE ENGINEER
SALEM, OREGON


1-4-71

Area in
Question

RECEIVED


STATE ENGINEER
SALEM, OREGON

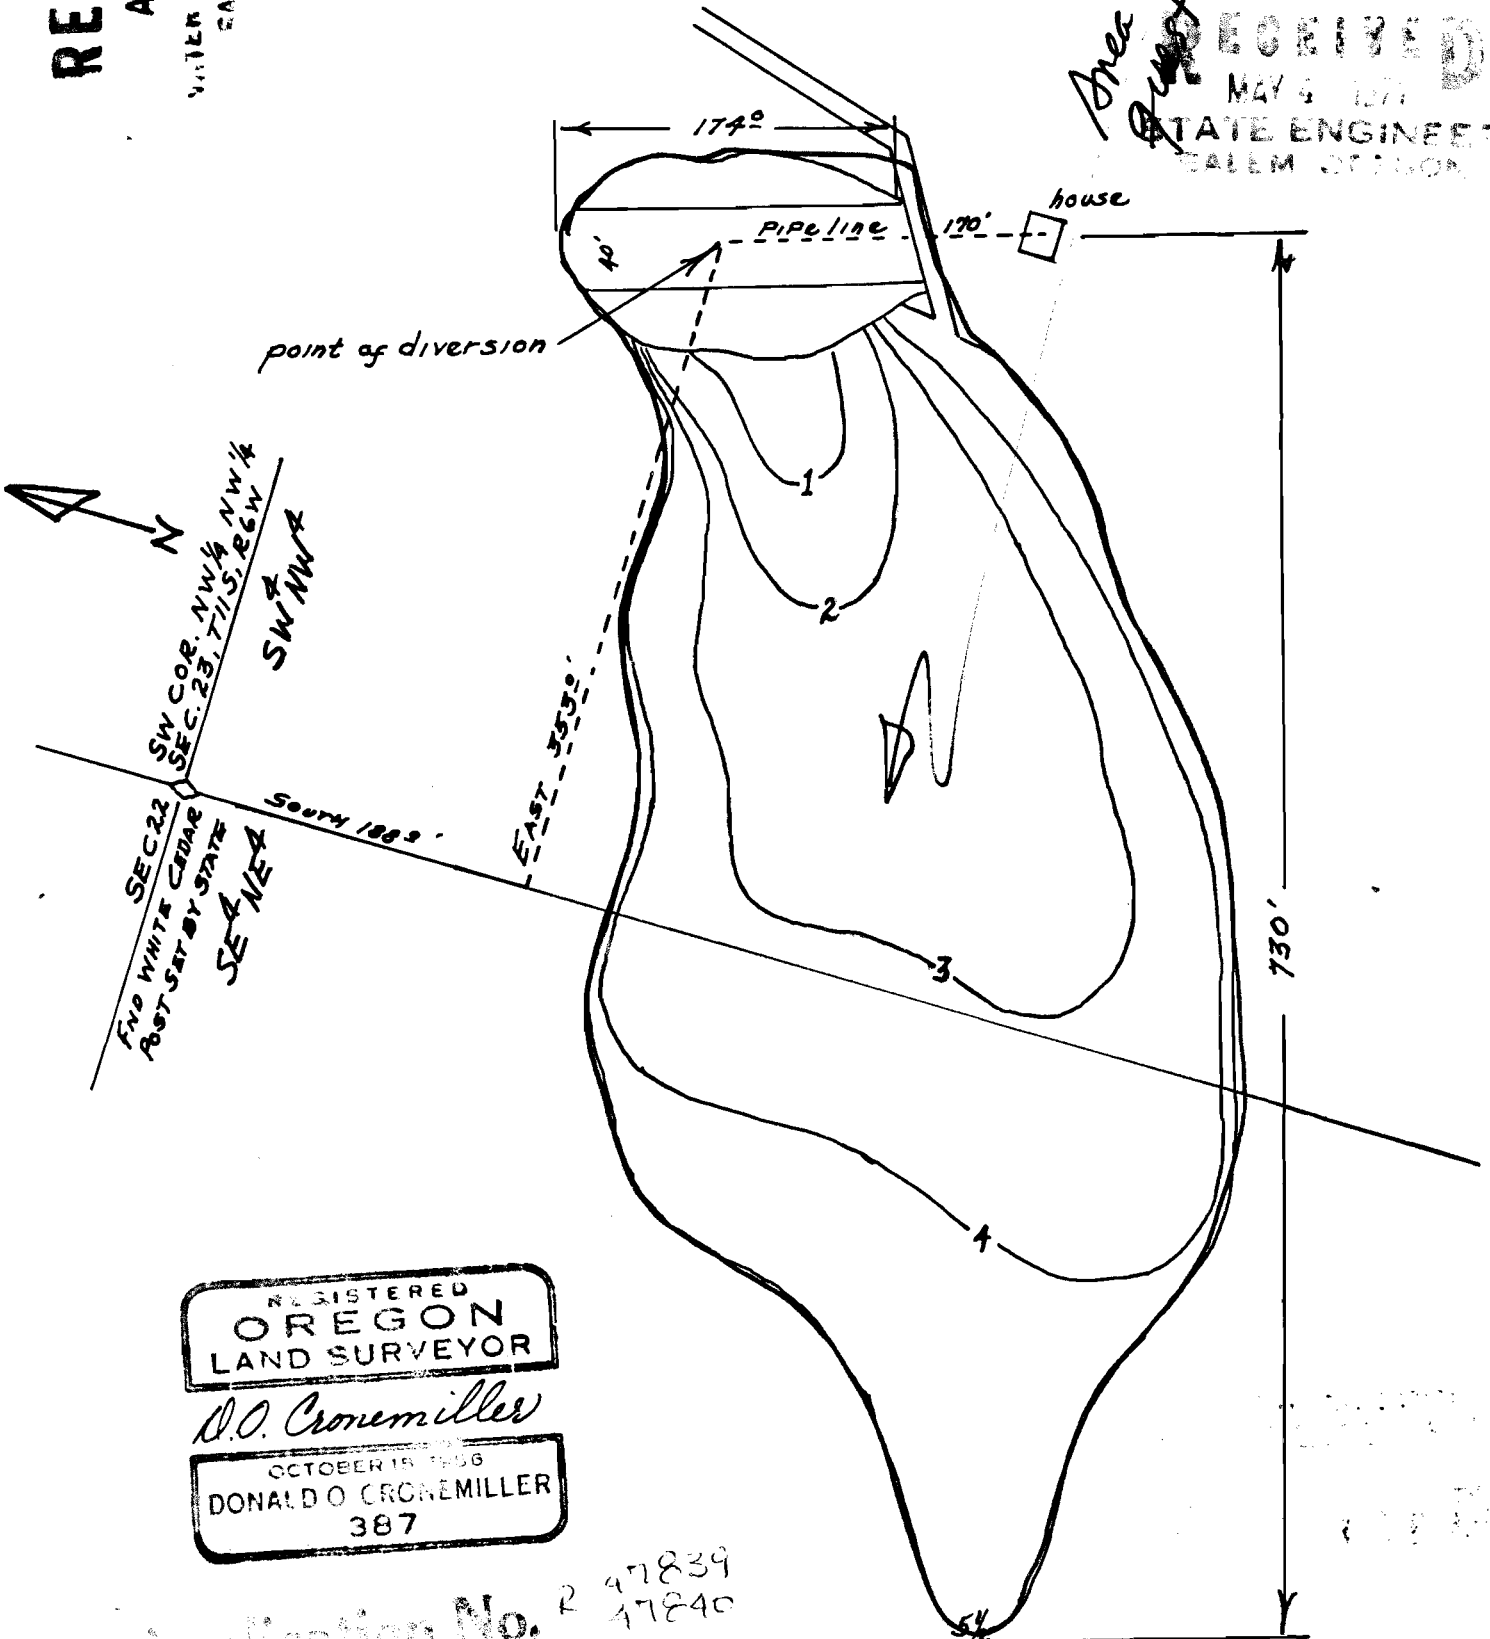

REGISTERED
OREGON
LAND SURVEYOR

D.O. Cronemiller

OCTOBER 15 1966
DONALD O. CRONEMILLER
387

Location No.

Block No.

47839
47840