


T.5S. R.1W. W.M

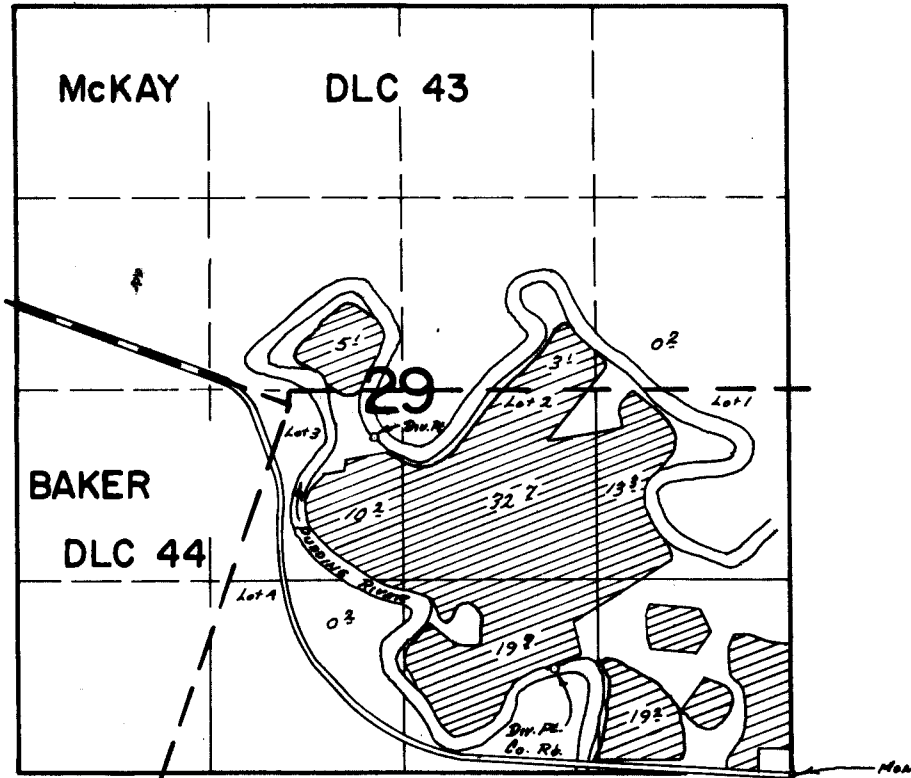

Div. Pts. Loc. "1 2300' N & 2860' W " 2 700' N & 1630' W
Both From S.E. Cor Sec. 29

FINAL PROOF SURVEY UNDER

Application No. 12182 Permit No. 22204
IN NAME OF

LEONARD & CAROL OBERSINNER

Surveyed April 24 1972 by R.G. Mucken