


T.6S.,R.1E.,W.M.

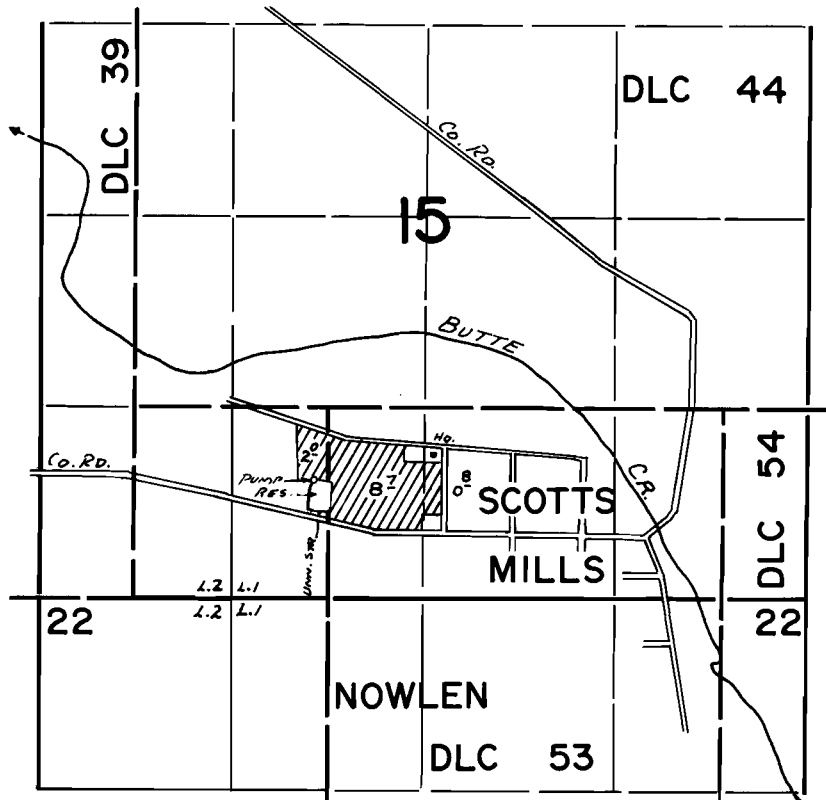

Div. Pt. Loc: 500'S AND 100'W FROM NE COR Lot 1 (SESW) SEC 15

FINAL PROOF SURVEY UNDER

R-50310 R-6145
 Application No. 50311 Permit No. 37986
 IN NAME OF

ARTHUR R. ROSENBLAD

Surveyed Aug. 11, 1976, by L. TOLL