


T. 4S. R. 25E. W.M.

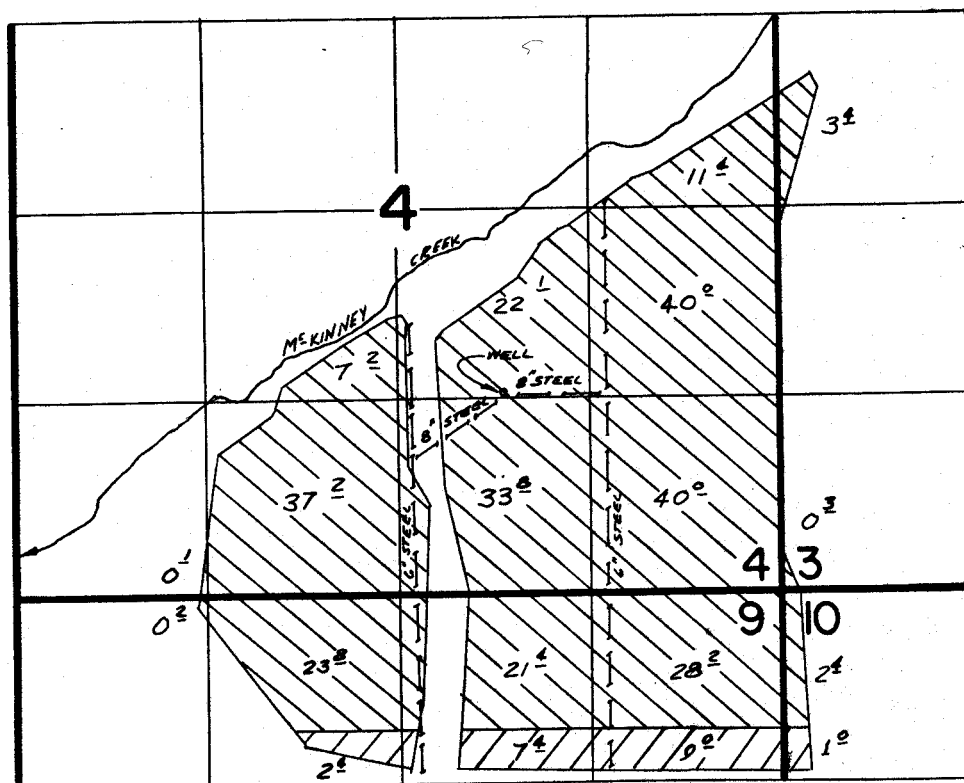

WELL LOCATED 1380' N. & 1890' W. FROM SE COR SEC 4



FINAL PROOF SURVEY UNDER

Application No. G.6355 Permit No. G.5055
IN NAME OF

HORSESHOE HEREFORD RANCH

Surveyed DEC. 12 1977, by R. BARWIN