


T.1N&1S, R.26E.W.M.

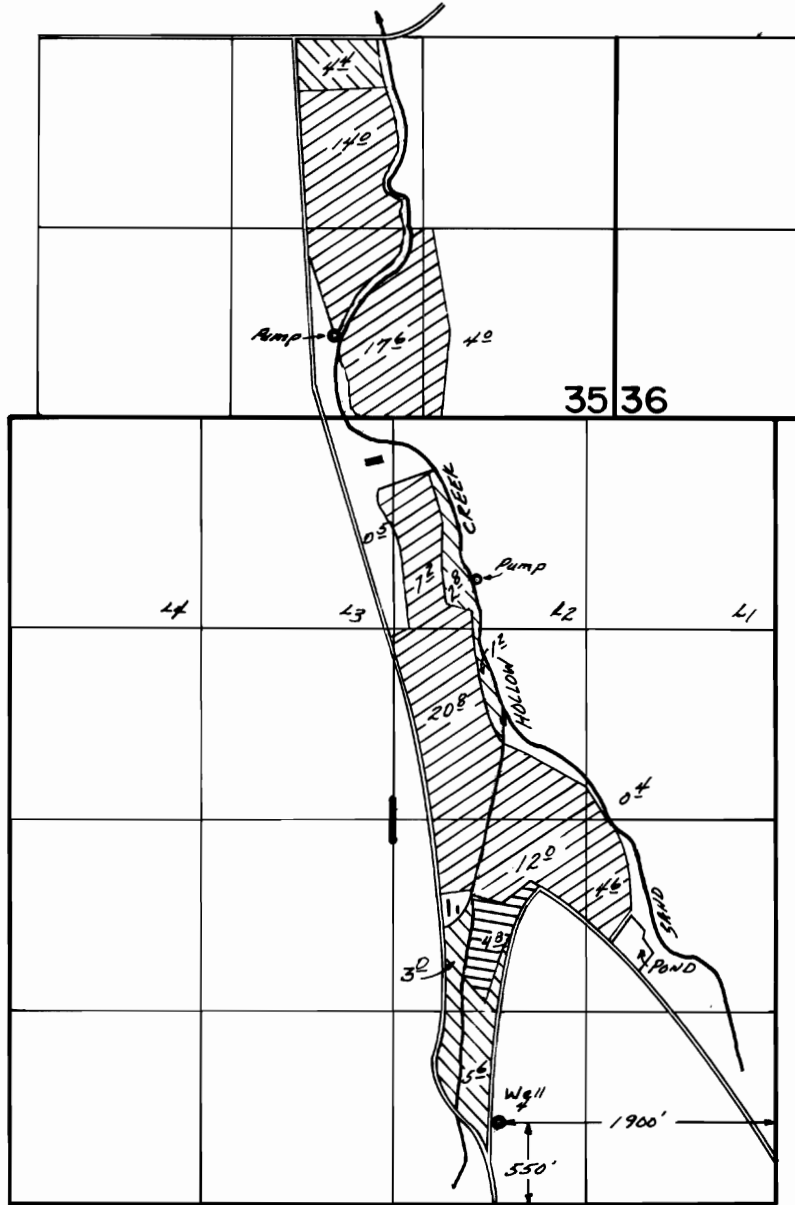

FINAL PROOF SURVEY

UNDER




TRANSFER No. 4094

Application No. G-7014. Permit No. G-6514.....

IN NAME OF

.....FRITZ...CUTSFORTH.....

Surveyed .DEC. 20. 1977., by .R. BARWIN.....

-  -Primary G-7014
-  -Suppl. G-7014
-  Tr 4094