


T.7S. R.6W. W.M.

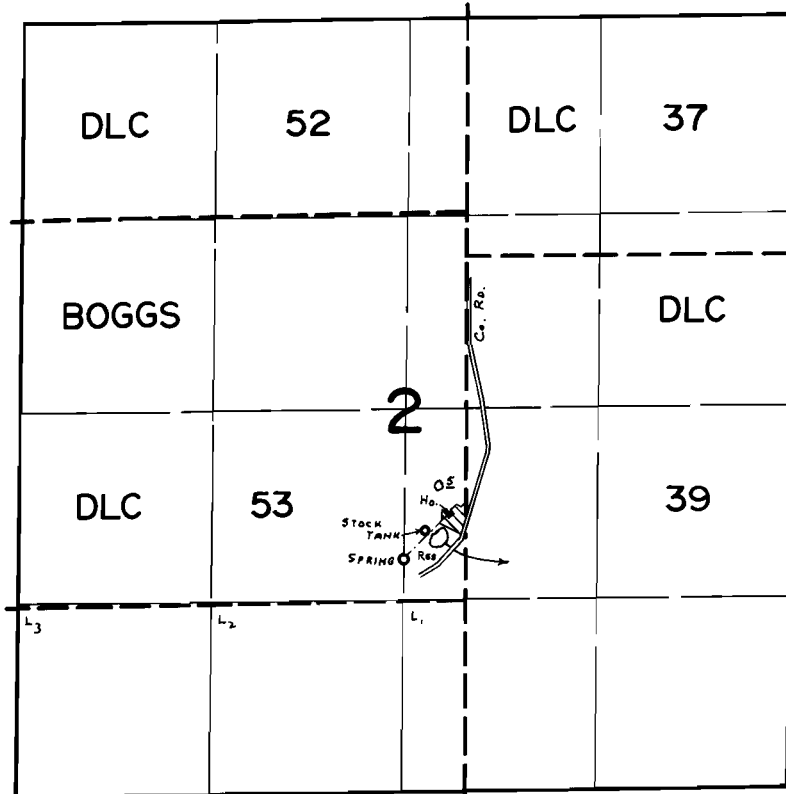

SPRING Loc: 290' N. & 420' W. } BOTH FROM S.E. COR. D.L.C. 53.
 Res. Loc: 380' N. & 130' W. }

FINAL PROOF SURVEY UNDER

R-53498 R-6386
 Application No. 53499. Permit No. 39873.....

IN NAME OF

.....ROBERT MOORE.....

Surveyed May 29, 1979, by R.G. Mucken.....