


# T. 3 S., R. 8 W., W.M.

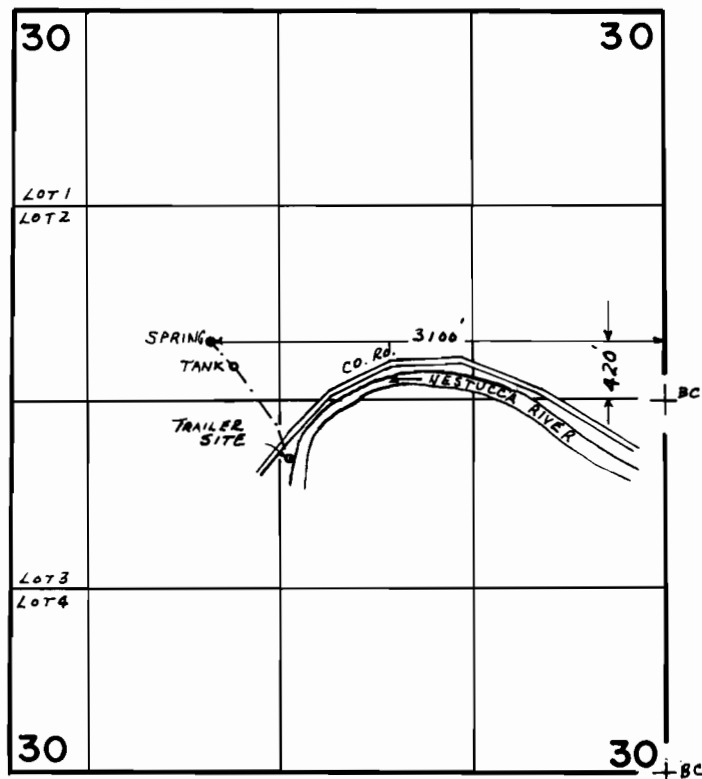

## FINAL PROOF SURVEY UNDER

Application No. 52267 Permit No. 39331  
IN NAME OF

**MAX W. & GLADYS WINDER**

Surveyed Apr. 4 1978, by J.S. DONALDSON